


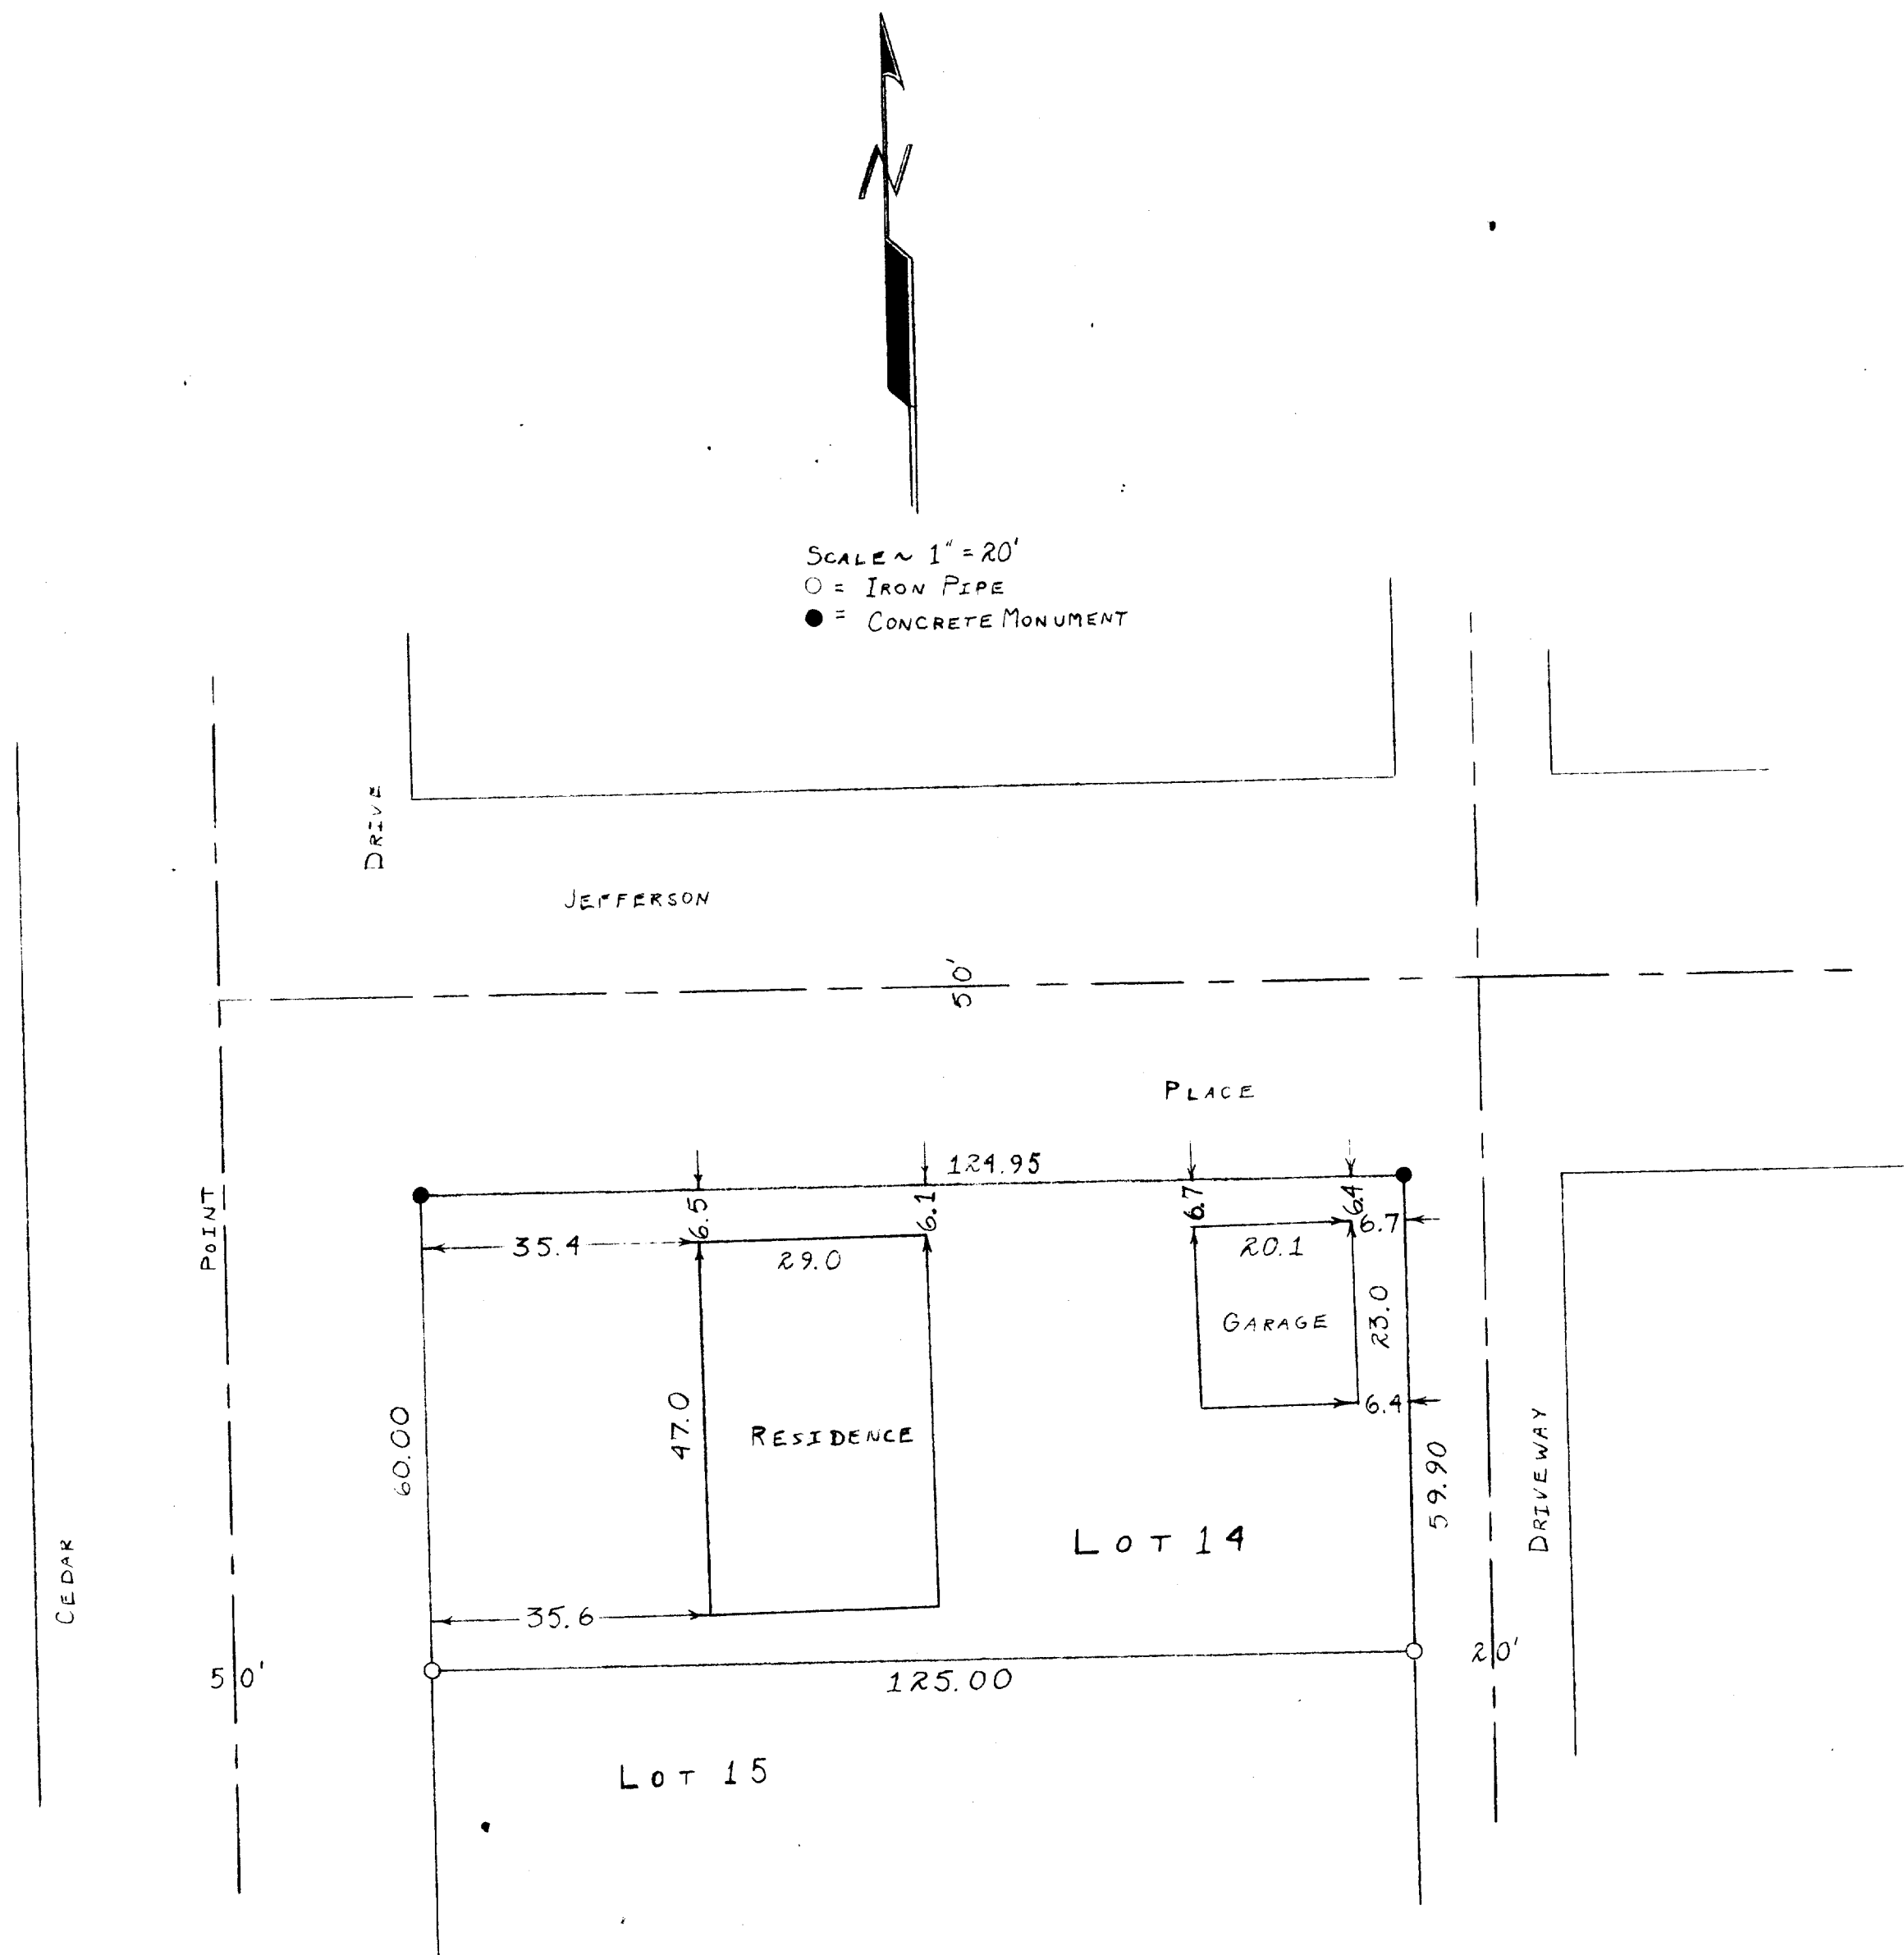

STATE OF WISCONSIN) SS
WALWORTH COUNTY)

I, GEORGE T. DUNHAM, DO HEREBY CERTIFY THAT I HAVE
SURVEYED THE PROPERTY DESCRIBED AS FOLLOWS:
LOT 14 OF CEDAR POINT PARK, VILLAGE OF WILLIAMS BAY,
WALWORTH COUNTY, WISCONSIN
AND THAT THE ABOVE PLAT IS A CORRECT REPRESENTATION OF THE
PROPERTY LINES AND THE IMPROVEMENTS LOCATED THEREON.
JULY 14, 1959

George T. Dunham
GEORGE T. DUNHAM, SURVEYOR
DELAWARE, WISCONSIN