


HAROLD H. KOLB

REGISTERED PROFESSIONAL LAND SURVEYOR
LAKE GENEVA, WISCONSIN

HUMBOLT PARKWAY - 50' WIDE

JACKSON PARKWAY - 50' WIDE

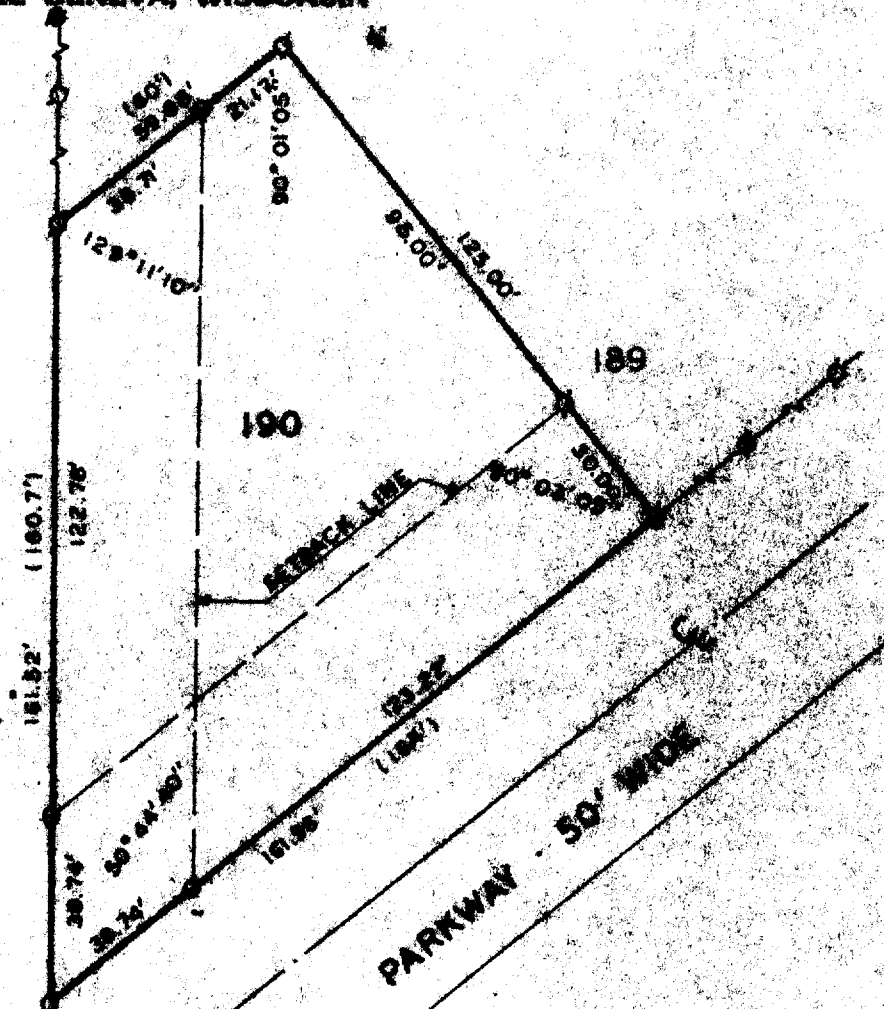

SCALE - 1" = 40'

LEGEND

- φ - IRON PIPE FOUND
- - IRON PIPE PLACED
- - CONCRETE MONUMENT
- x - SPIKE
- () - Platted As



PLAT OF SURVEY OF

Lot 190, Cedar Point Park
Subdivision, T1N, R17E,
Village of Williams Bay,
Walworth County, Wisconsin.

OWNER: John Cahill
ACCURACY: Distance ± 0.01'
Angles ± 05"
Error of Closure
less than 1/3000

I, HAROLD H. KOLB, DO HEREBY CERTIFY THAT I HAVE
SURVEYED THE PROPERTY HEREON DESCRIBED ACCORDING
TO THE OFFICIAL RECORDS, AND THAT THE PLAT HEREON
IS A CORRECT REPRESENTATION OF THE LOT LINES.

Harold H. Kolb
HAROLD H. KOLB
WISCONSIN REGISTERED LAND SURVEYOR - 9-197
DATE Sept. 29, 1979

WCP-164

11-281