

PREPARED FOR
KEEFE REAL ESTATE



ORDERED BY
DAN OLESTON

PLAT OF SURVEY

- OF -

The South 30 feet of Lot 31 of Lockwood's Subdivision, in the
Village of Williams Bay, Walworth County, Wisconsin.

PATHFINDER SURVEYING
(a NMB Company)
P.O BOX 322
LAKE GENEVA, WI. 53147
WWW.PATHFINDERSURVEYING.NET
262-248-8303

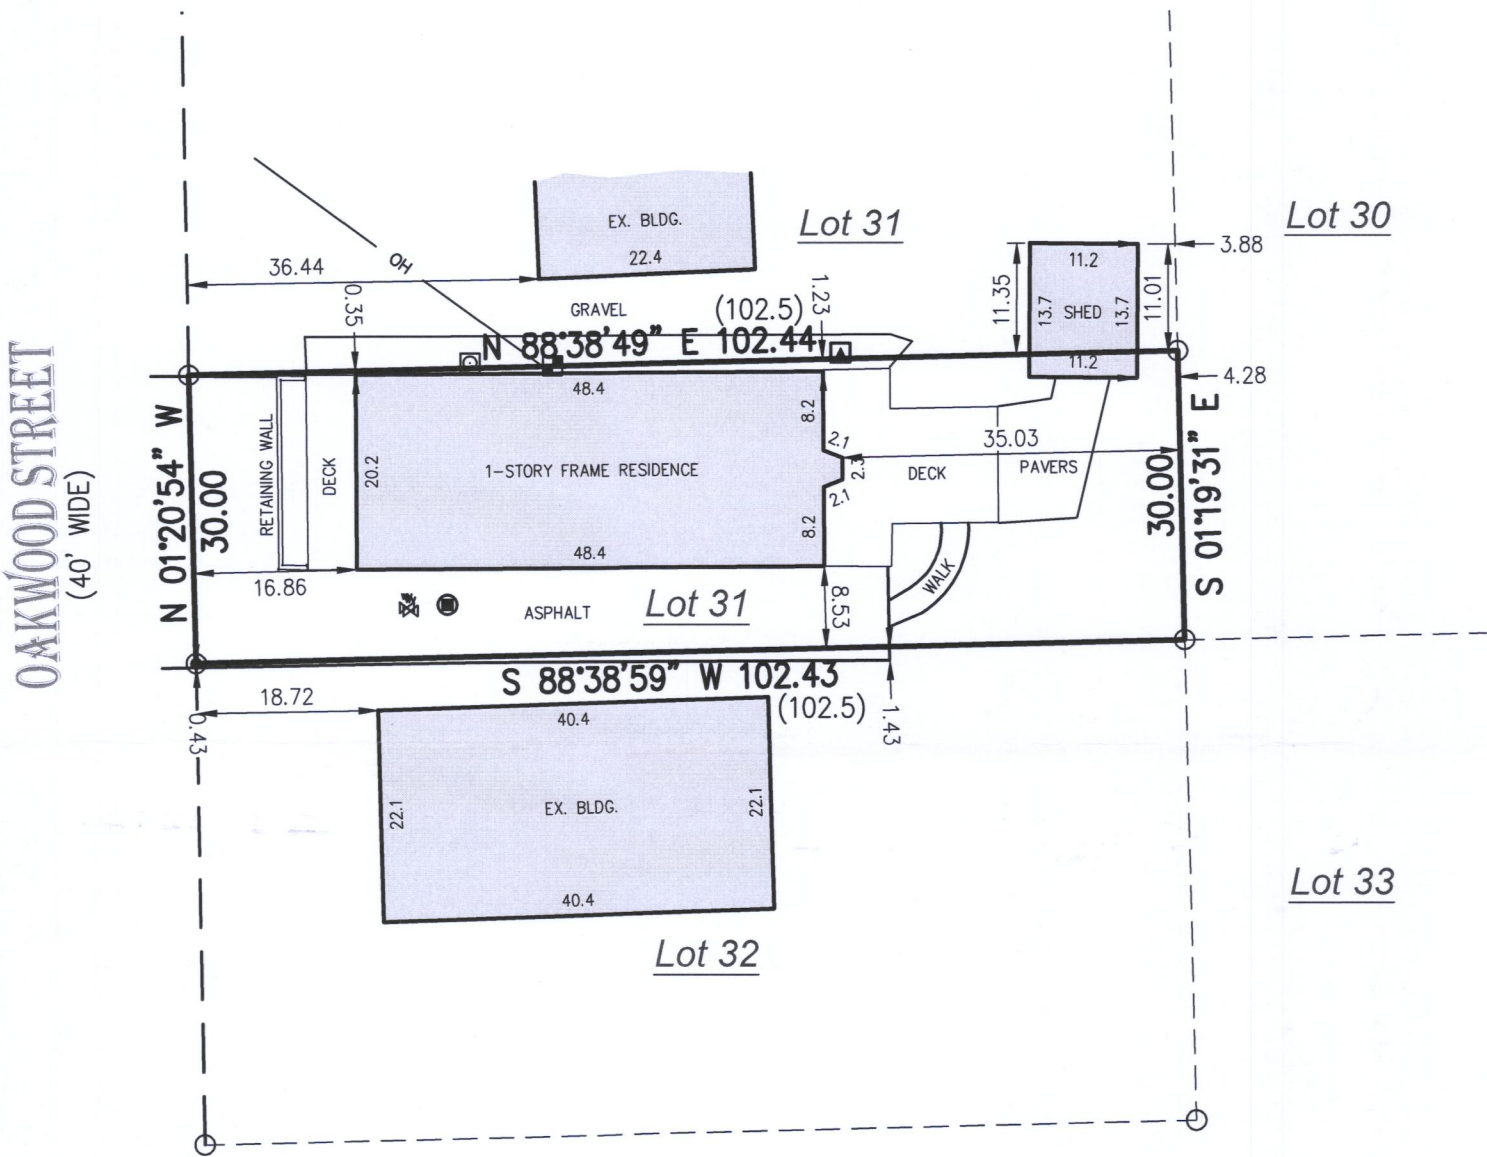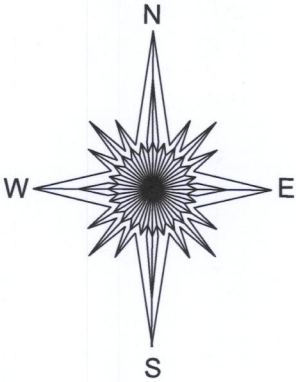


- () = recorded as
- WV = water valve
- = found iron pipe
- OH— = overhead wires
- = electric meter
- ▲ = hvac
- = misc manhole
- = gas meter

SCALE 1" = 20'

JOB # 2018.0097.01

TAX ID # WLW3 00022

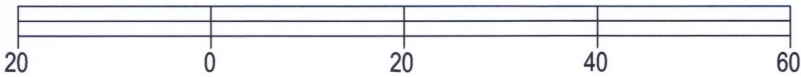


BASIS OF BEARING OF THIS PLAT: THE US STATE PLANE
COORDINATE SYSTEM SOUTH ZONE, NAD 83. WISCORS.

I hereby certify that I have surveyed the above- described property and the
above map is a true representation thereof and shows the size and
location of the property, its exterior boundaries, the location and dimensions
of all structures thereon, fences, apparent easements and roadways and
visible encroachments if any to the best of my knowledge and belief.

This survey is made for the present owners of the property, and those who
purchase, mortgage, or guarantee the title thereto, within one year from the
date hereof.

DATED THIS 12TH DAY OF APRIL, 2018.

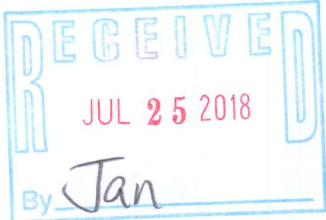

Mark R. Madsen
MARK R. MADSEN S - 2271
Wisconsin Professional Land Surveyor

WLW3-22 011-2843