FARRIS, HANSEN & ASSOCIATES, INC.

ENGINEERING - ARCHITECTURE - SURVEYING
7 RIDGWAY COURT - P.O. BOX 437 - ELKHORN, WISCONSIN 53121
PHONE: (262) 723-2098 FAX: (262) 723-5886


PLAT OF SURVEY

- WORK ORDERED BY -TIM BANGS 10309 COOK AVE. OAK LAWN, ILLINOIS 60453

LOT 262 & LOT 265 EXC. S 28' CEDAR POINT PARK 3RD ADD.

PART OF THE SW 1/4 OF THE SE 1/4 SECTION 6, TOWN 1 NORTH,

RANGE 17 EAST, VILLAGE OF WILLIAMS BAY, WALWORTH COUNTY, WISCONSIN

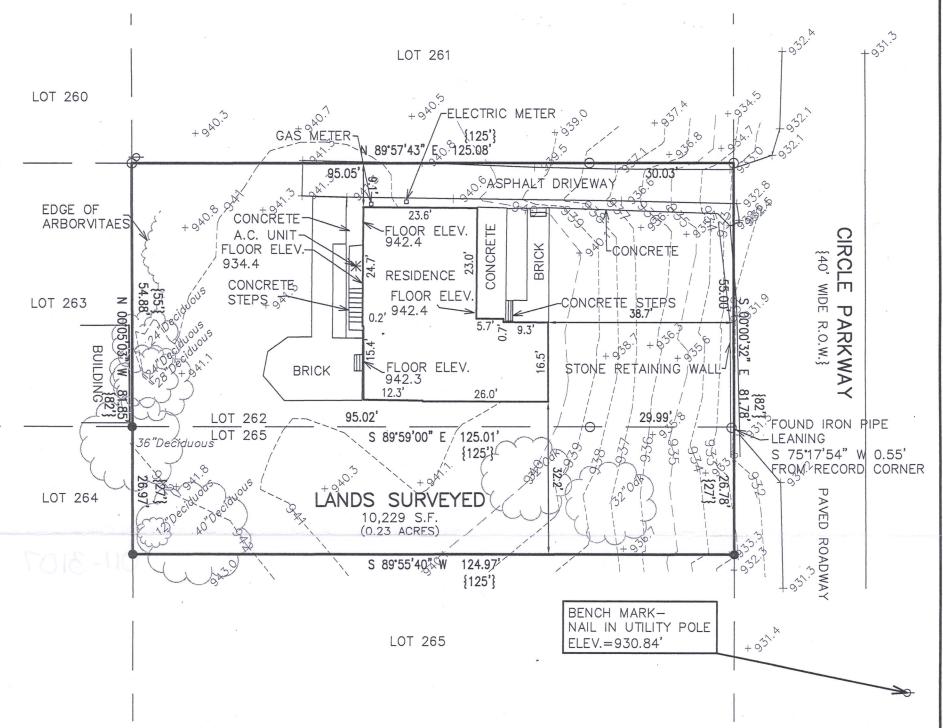



LEGEND

O = FOUND IRON PIPE STAKE

• = FOUND IRON REBAR STAKE

- → = UTILITY POLE

{XXX} = RECORDED AS

NOTE: COPIES OF THIS MAP TO WHICH THE FOLLOWING CERTIFICATE WILL APPLY SHOW THE SURVEYOR'S ORIGINAL SEAL AND SIGNATURE IN RED INK. COPIES BY ANY OTHER MEANS MAY HAVE ALTERATIONS WHICH DO NOT REPRESENT THE SURVEYOR'S WORK PRODUCT.

I HEREBY CERTIFY THAT THE ABOVE DESCRIBED PROPERTY HAS BEEN SURVEYED UNDER MY DIRECTION AND THAT THE ABOVE MAP IS A TRUE REPRESENTATION THEREOF AND SHOWS THE SIZE AND LOCATION OF THE PROPERTY AND ITS EXTERIOR BOUNDARIES. THIS SURVEY IS MADE FOR THE USE OF THE PRESENT OWNERS OF THE PROPERTY, AND ALSO THOSE WHO PURCHASE, MORTGAGE, OR GUARANTEE THE TITLE THERETO WITHIN ONE YEAR FROM THE DATE HEREOF.

By 8/16

12/9/2021 DATED: _____

CHRISTOPHER A. HODGES P.L.S. 2760

20 10 0 20 40 60 MAP SCALE IN FEET - ORIGINAL 1"=20'

> PROJECT: 10596 DATE: 12/09/2021 SHEET 1 OF 1

VCP3-53

x:\PROJECTS\10596\ACAD\10596.dwg

011-3107

011-2101

80