
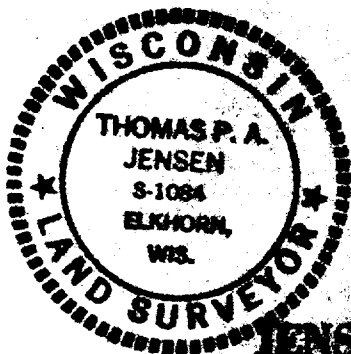


PLAT OF SURVEY

OF

LOTS 6 & 7, BLOCK B WILLIAMS 1ST ADDITION,
A SUBDIVISION LOCATED IN THE NE 1/4 OF SECTION 1,
T1N R1E, VILLAGE OF WILLIAMS BAY, WALWORTH
COUNTY, WISCONSIN.

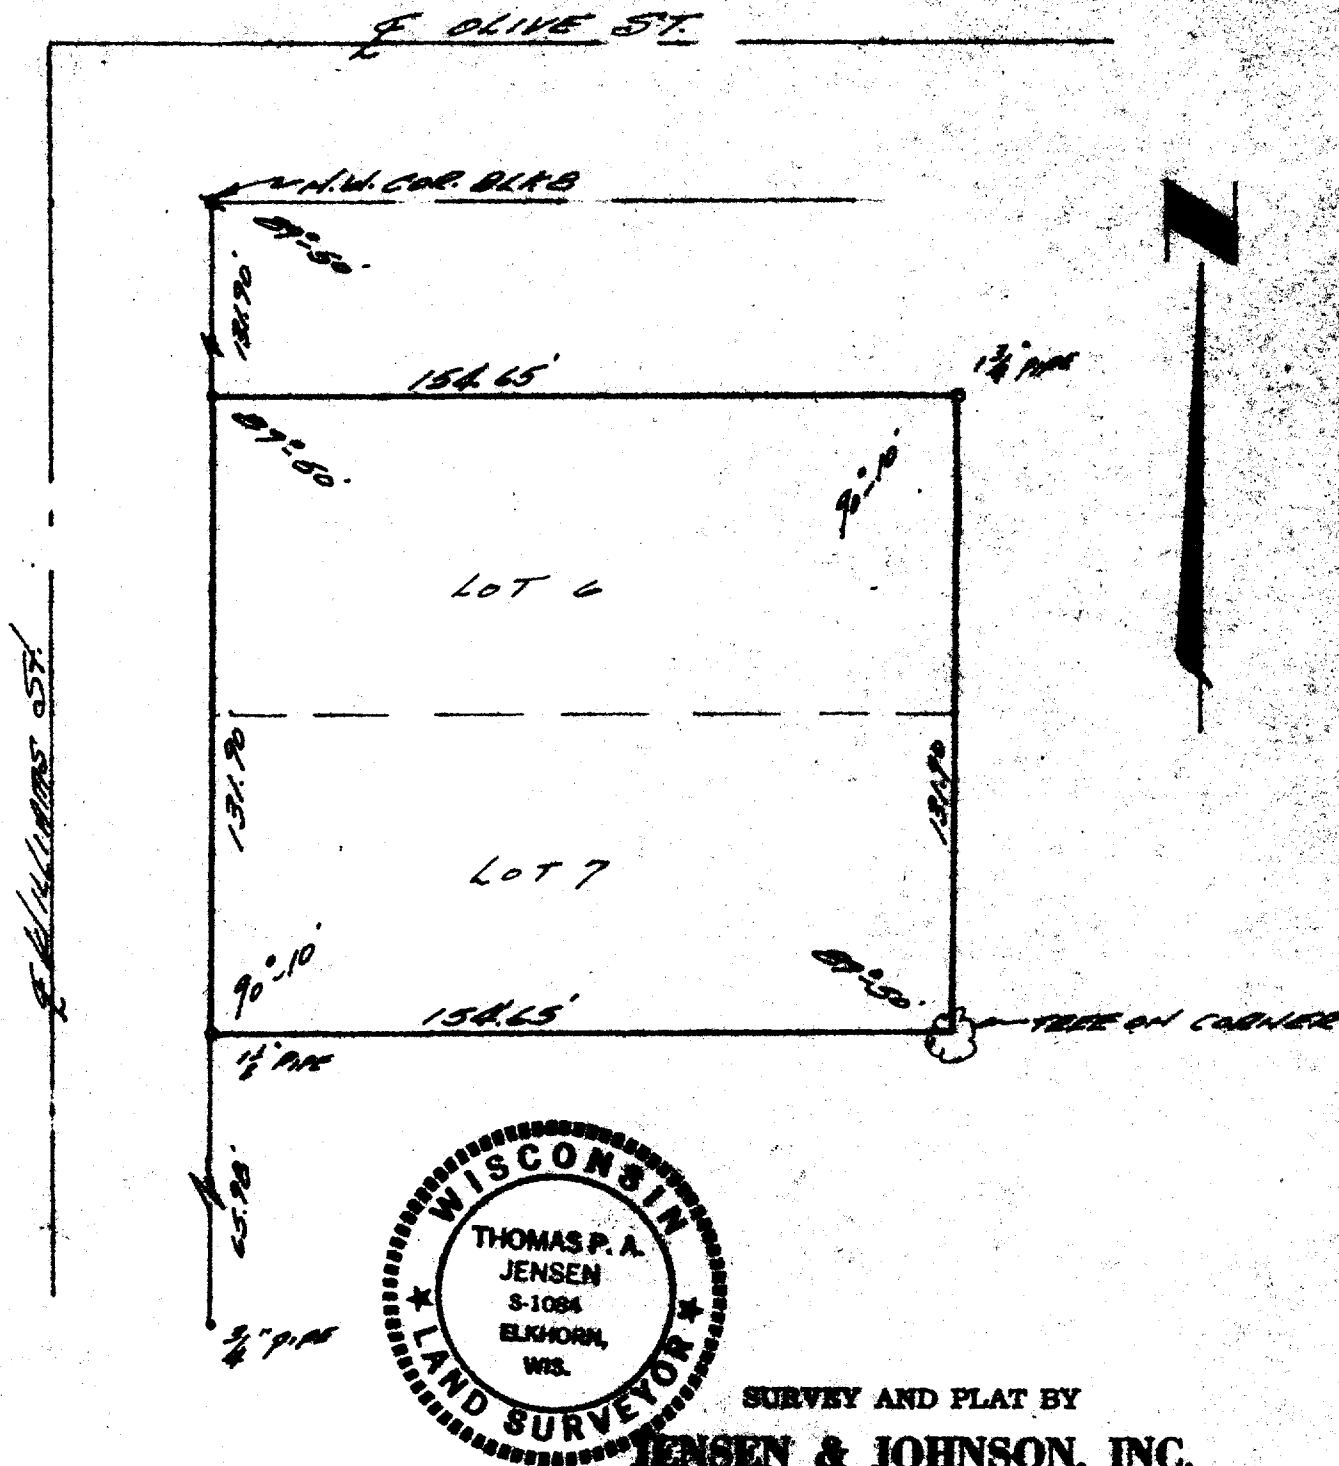

SURVEY AND PLAT BY

JENSEN & JOHNSON, INC.
CIVIL ENGINEERS AND SURVEYORS

Elkhorn, Wisconsin

LEGEND

- — Iron Pipe FOUND
- — Concrete Monument FOUND
- Scale 1" = 40'
- — 3/4" x 24" IRON ROD SET

WE CERTIFY: That we have surveyed the above described property and that the plat shown herein is an accurate survey and a true representation thereof and correctly shows the exterior boundary lines and all divisions of said property.

Date JULY 6, 1976

Thomas P. A. Jensen

Wisconsin Registered Land Surveyor, No. 8-1084

SURVEYED FOR:
THEODORE G. HUBNER
208 KINGSTON DR
ADRIAN, ILLINOIS 6001