


HAROLD H. KOLB

REGISTERED PROFESSIONAL LAND SURVEYOR
LAKE GENEVA, WISCONSIN

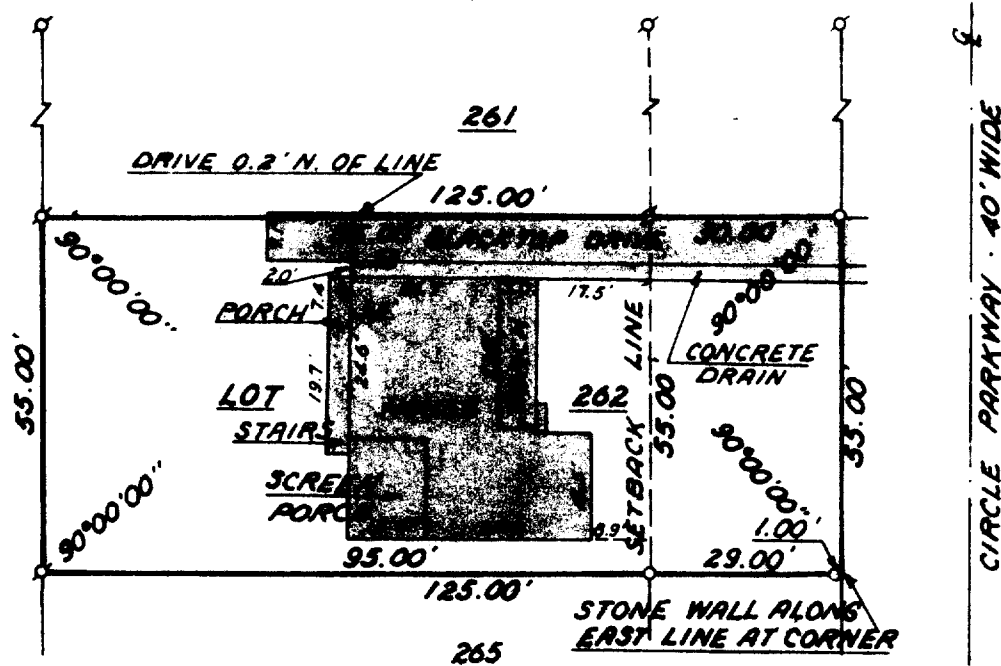

PLAT OF SURVEY OF

LOT 262, CEDAR POINT PARK 3RD ADDITION, VILLAGE
OF WILLIAMS BAY, WALWORTH COUNTY, WISCONSIN.


ORDERED BY: OSCAR ANDERSON

ACCURACY: DISTANCES $\pm 0.01'$
ANGLES $\pm 5''$
ERROR OF CLOSURE - LESS
THAN ONE PART IN 3000



LEGEND

- φ — IRON PIPE FOUND
- — IRON PIPE PLACED
- — CONCRETE MONUMENT
- x — SPIKE

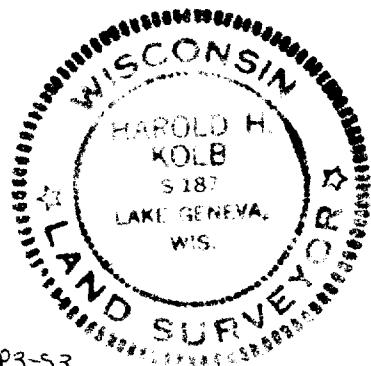

I, HAROLD H. KOLB, DO HEREBY CERTIFY THAT I HAVE
SURVEYED THE PROPERTY HEREON DESCRIBED ACCORDING
TO THE OFFICIAL RECORDS, AND THAT THE PLAT HEREON
IS A CORRECT REPRESENTATION OF THE LOT LINES.

HAROLD H. KOLB
WISCONSIN REGISTERED LAND SURVEYOR, S-187
DATE July 27, 1976