


CLEVELAND PARKWAY

30 FEET WIDE

PUBLIC STREET

CEDAR POINT DRIVE
50 FEET WIDE
PUBLIC STREET

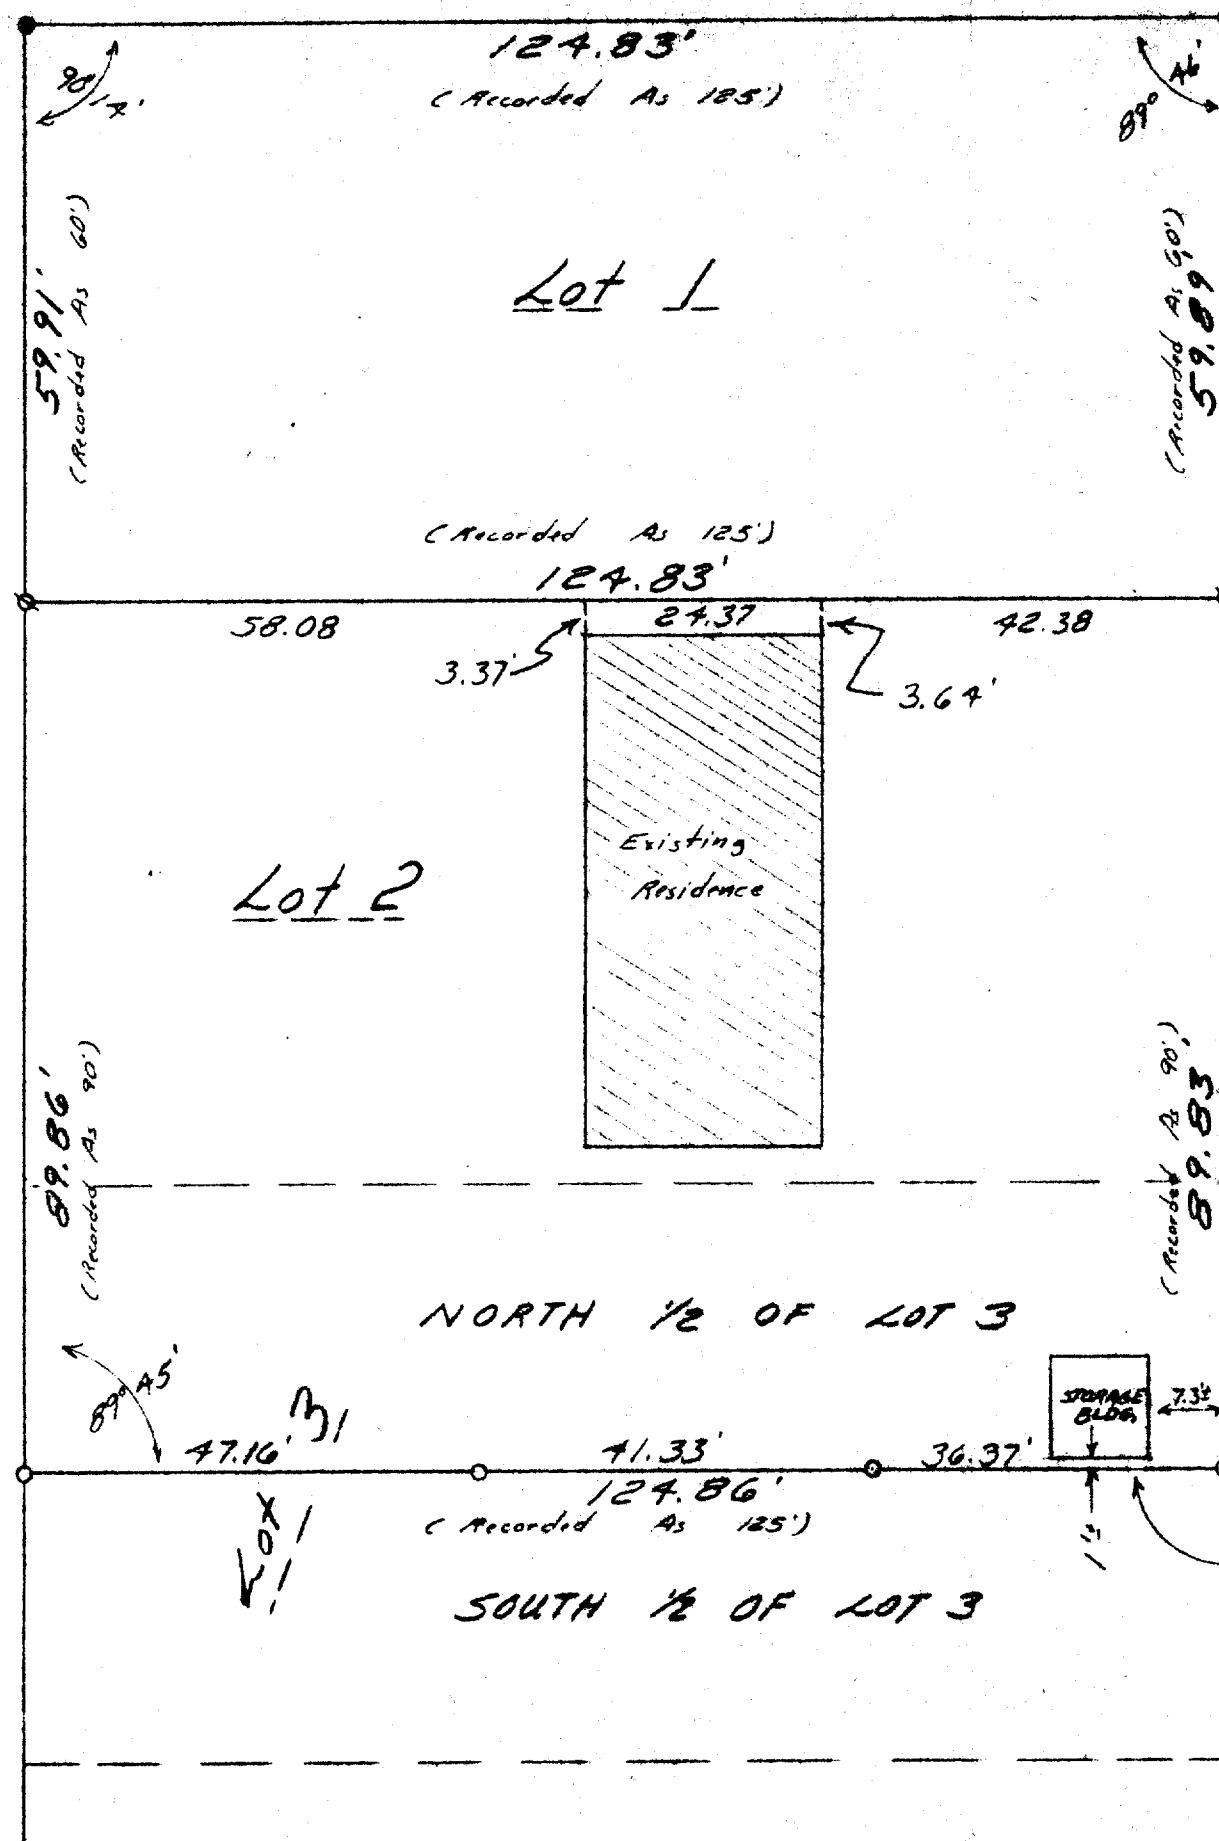

Lot 73

Lot 74

Lot 75

- Legend**
- = 1" x 24" iron pipe set
 - = 1" iron pipe found
 - = 5" dia. concrete monument found

North As Shown on Plat of Cedar Point Park

I, Lloyd L. Jensen, surveyor, do hereby certify that under my direction the lands shown hereon have been surveyed and mapped, and that this Plat of Survey is a true and accurate representation of the lot lines and building location to the best of my knowledge and belief.

Dated this 28th day of September, 1976

Lloyd L. Jensen
Lloyd L. Jensen (3211)

Survey and Plat ordered by Glen Johnson as Job # 1658.051

PLAT OF SURVEY OF

Lot 1, Lot 2, and the North 1/2 of Lot 3 of Cedar Point Park located in the Northeast 1/4 of Section 6, Town 1 North, Range 17 East, Village of Williams Bay, Walworth County, Wisconsin

SCALE 1" = 30 Feet

DATE 28 Sept. 1976

11-329J