


CLEVELAND
PARKWAY
50 FEET
WIDE

Sanitary Sewer
NH # 16
D = 27.82
D = 13.325
I.E. 100.46 E.
I.E. 100.12 S.

CEDAR POINT DRIVE

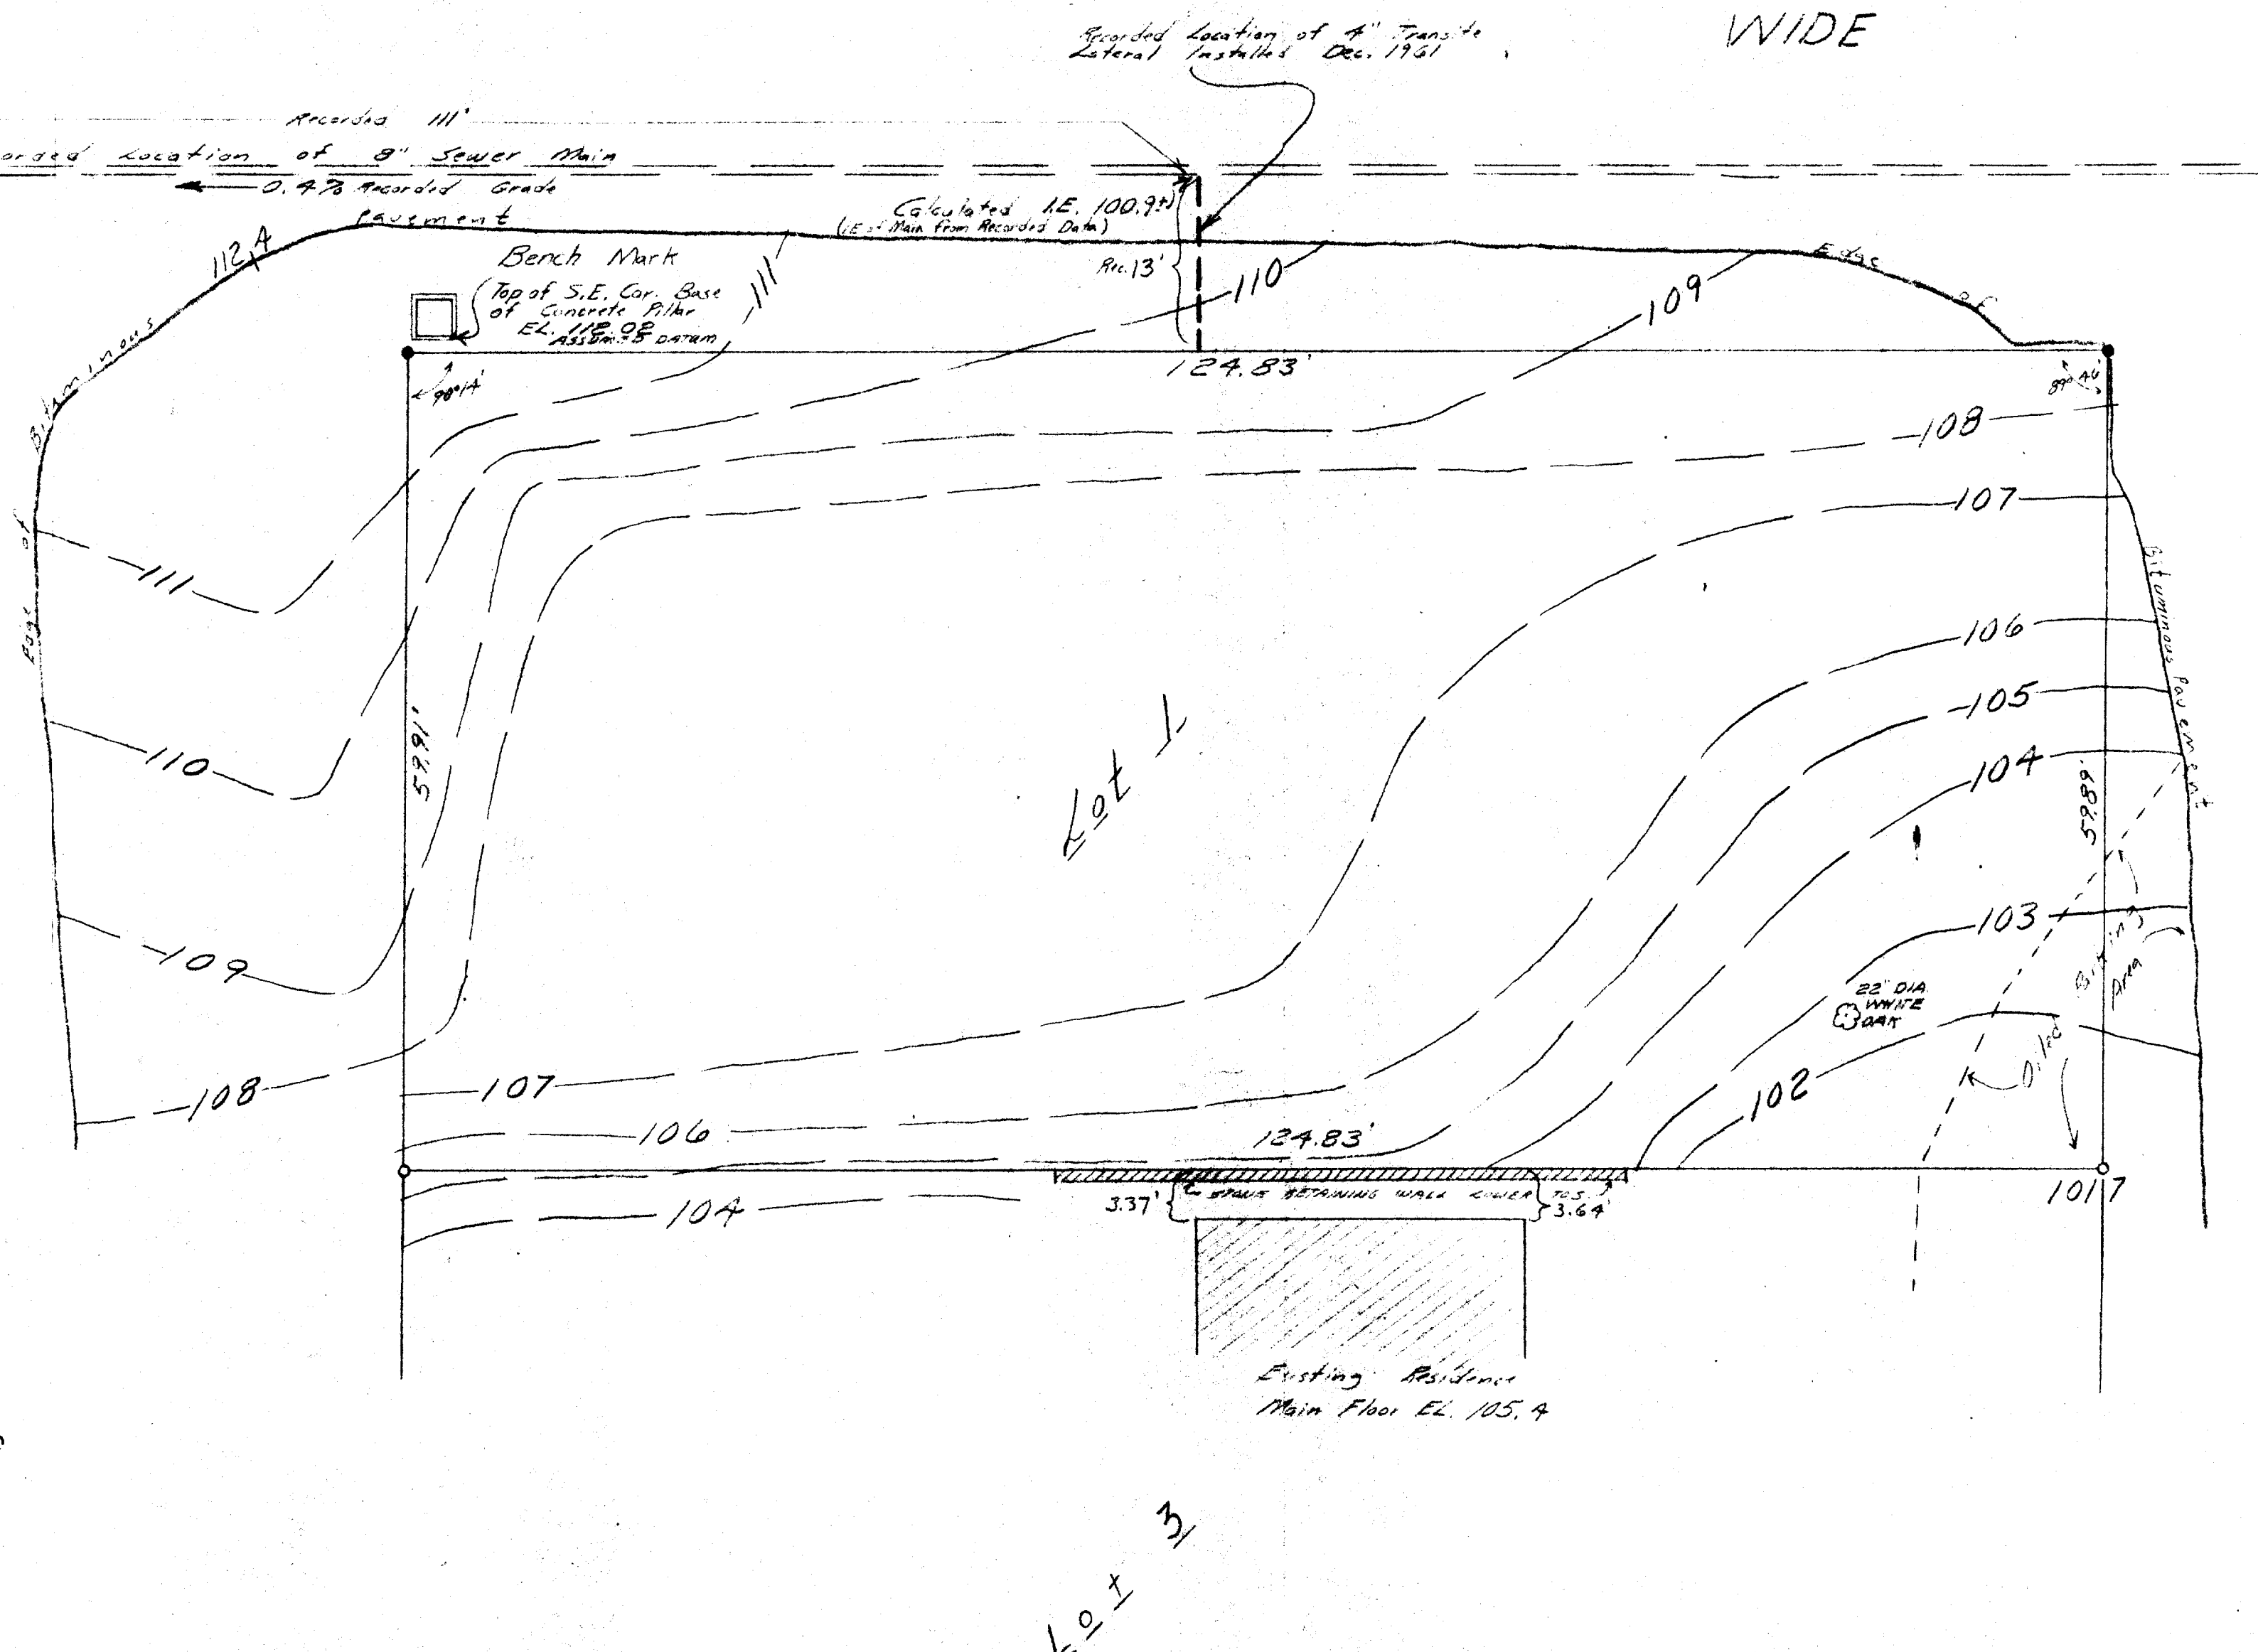

DRIVEWAY

Lot 13

Lot 14

Lot 3

- Legend:
- = 1" Dia. 24" Iron Pipe Set
 - = 5" Dia. Conc. Monument Found



Map Ordered by
Glen Johnson Job # 1658.051

Topographic Map of LOT 1 OF CEDAR POINT PARK LOCATED IN NE 1/4 SEC. 6, T.1N, R.17E VILLAGE OF WILLIAMS 34Y, WALWORTH COUNTY, WIS.		
DRAWN BY T.A.F.	JENSEN & JOHNSON CIVIL ENGINEERS ELKHORN, WIS.	SCALE: 1" = 10'
CHECKED BY <i>[Signature]</i>	APPROVED BY <i>[Signature]</i>	REVISION SHEET NO. OF
DATE 28 SEPT. 1976		

