


PLAT OF SURVEY

OF

LOT 2, EAST 120 FEET OF LOT 3, OBSERVATORY
SUBDIVISION, SECTION 1, T1N-R1E, WILLIAMS TWP,
WILMINGTON COUNTY, WISCONSIN.

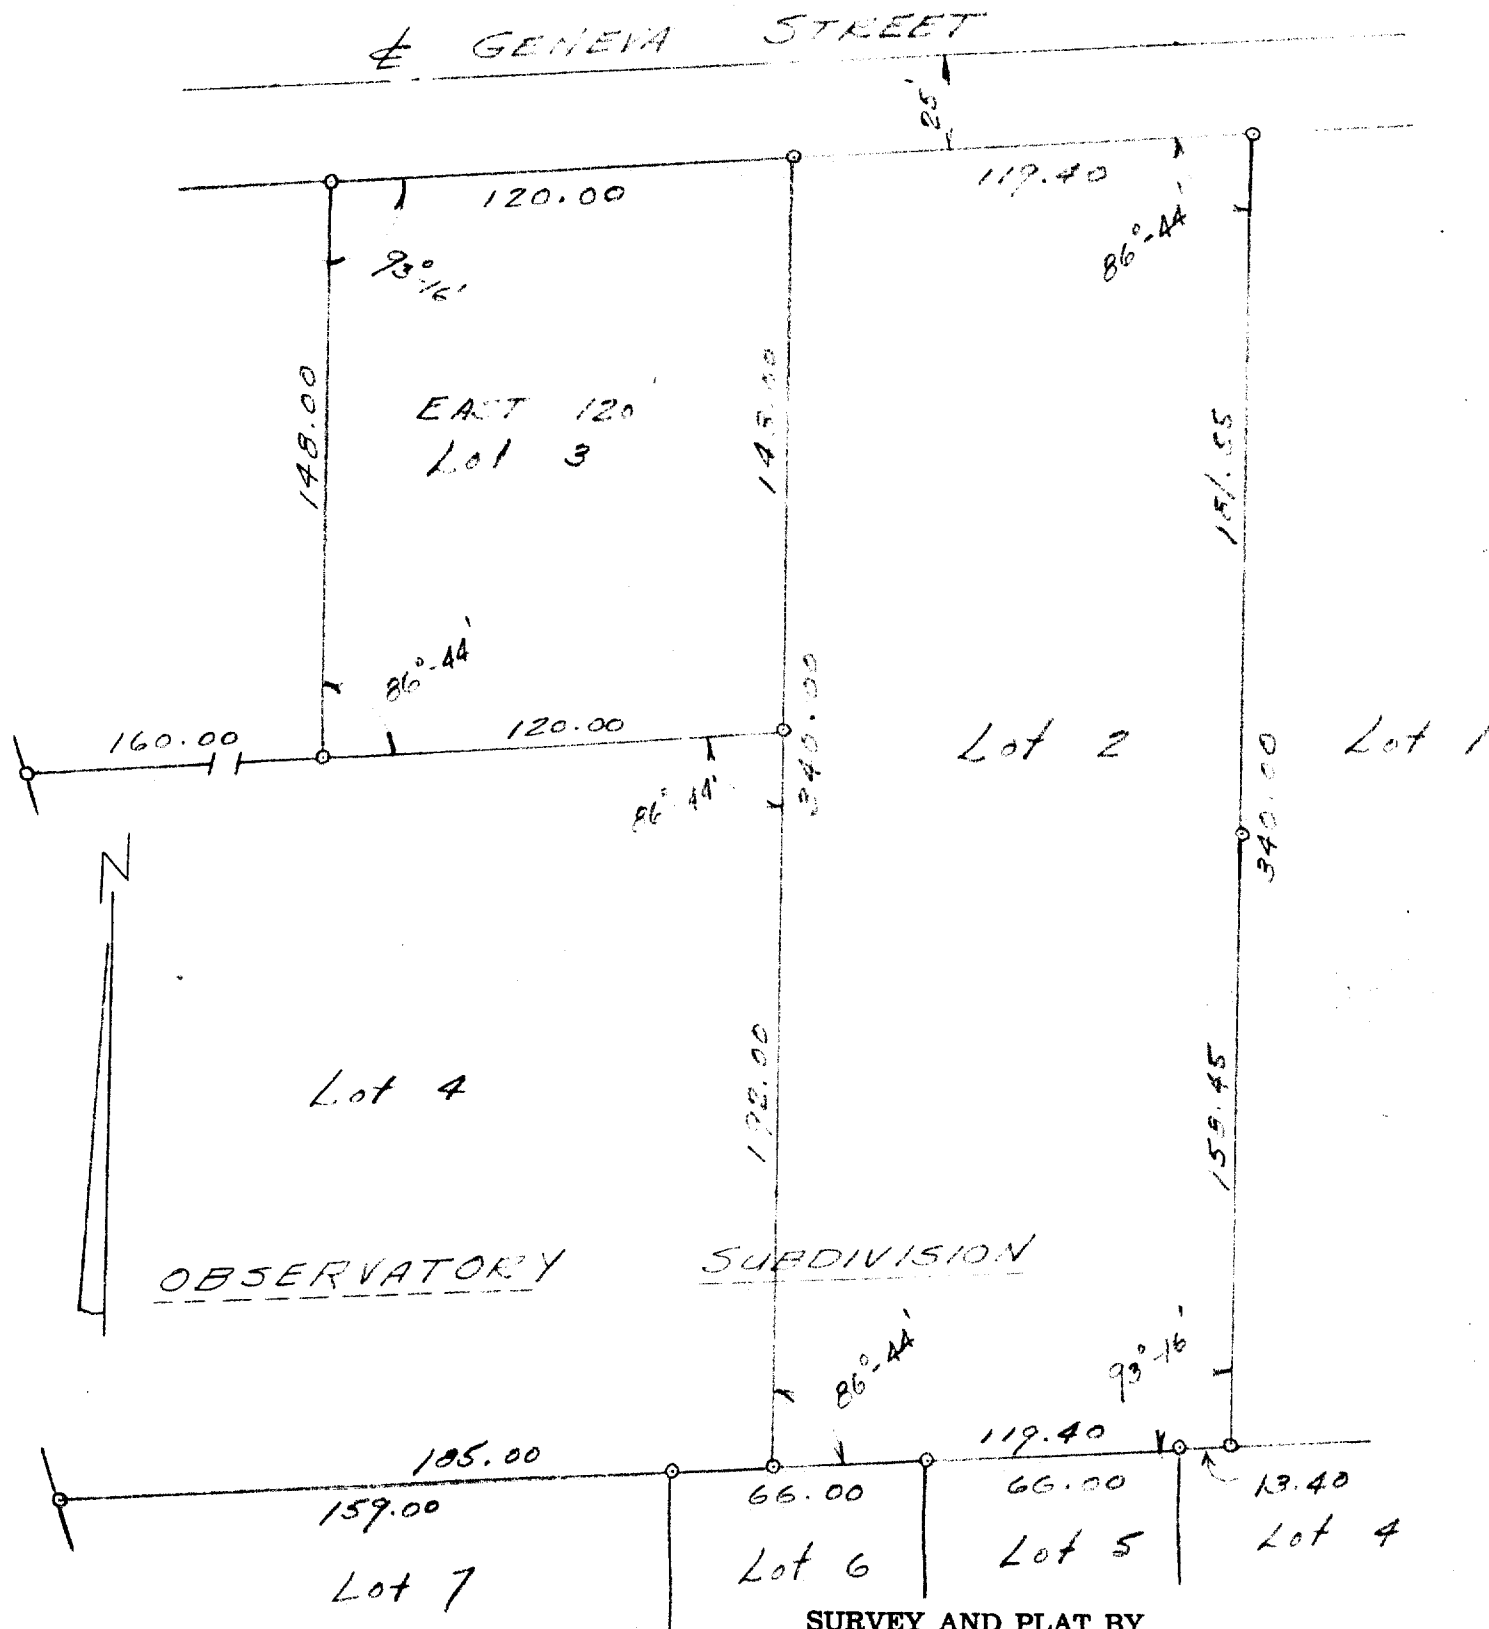

LEGEND

- — Iron Pipe
- — Concrete Monument
- Scale 1" = 50'

WE CERTIFY: That we have surveyed the above described property and that the plat shown hereon is an accurate survey and a true representation thereof and correctly shows the exterior boundary lines and all divisions of said property.

Date January 1966

Lloyd L. Jensen
LLOYD L. JENSEN,

Wisconsin Registered Land Surveyor, No. S-211