


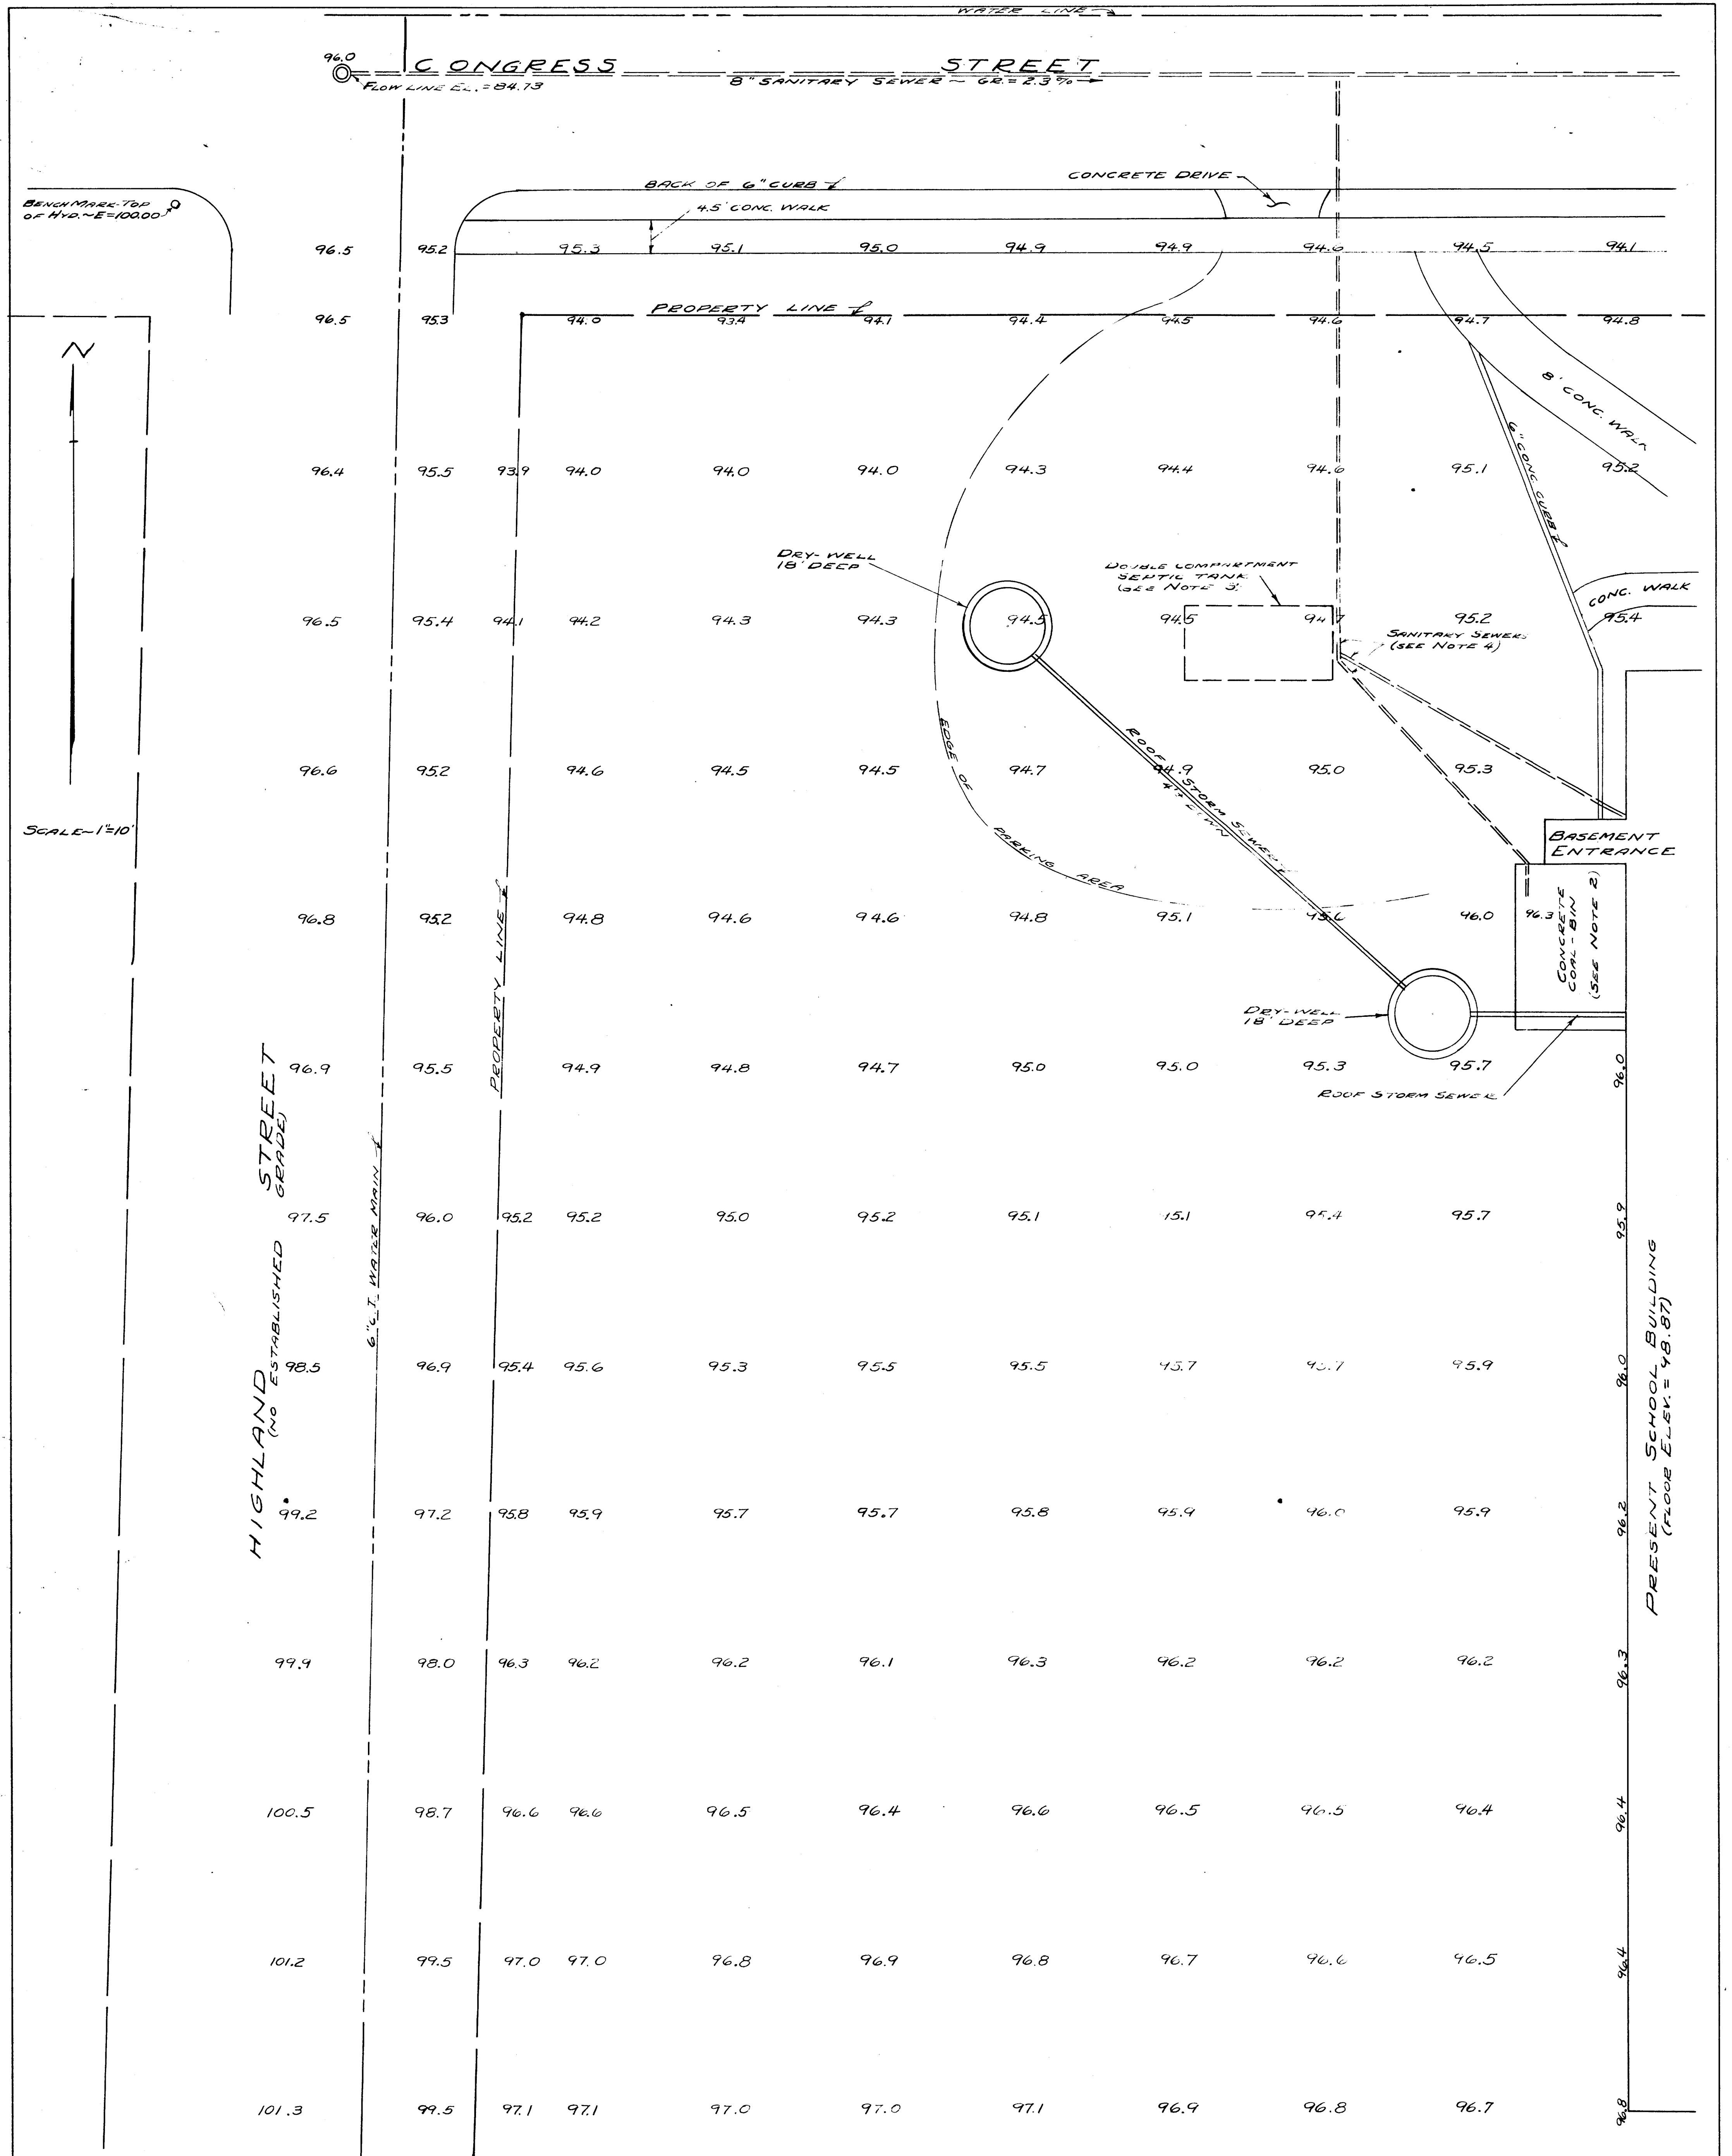

- NOTES:
1. ALL ELEVATIONS ARE INDICATED BY THE DECIMAL POINT.
 2. COAL BIN SLAB IS NOT DESIGNED TO CARRY TRUCKS. ALL UNLOADING MUST BE DONE FROM THE WEST END OF COAL BIN WITH TRUCK FACING WEST
 3. THE ABANDONED SEPTIC TANK SHOWN IS NOT LOCATED ACCURATELY BECAUSE THERE ARE NO INDICATIONS OF WHERE IT IS ON THE GROUND SURFACE. IT WAS LOCATED APPROXIMATELY BY CONVERSATION WITH E. JOHNSON, SCHOOL JANITOR.
 4. THE SANITARY SEWERS TO THE SCHOOL WERE LOCATED APPROXIMATELY BY CONVERSATION WITH E. JOHNSON.
 5. THERE IS NO SANITARY SEWER ON HIGHLAND STREET

PLAT OF SURVEY MADE OF PART OF THE WILLIAMS BAY SCHOOL GROUNDS, WILLIAMS BAY, WALWORTH COUNTY, WISCONSIN.

OCT. 11, 1946

H.E. Johnson
R.C.E. 2098