


DUNHAM SURVEYING, S.C.
SURVEYING & SUBDIVIDING
DELAVER, WISCONSIN 53115

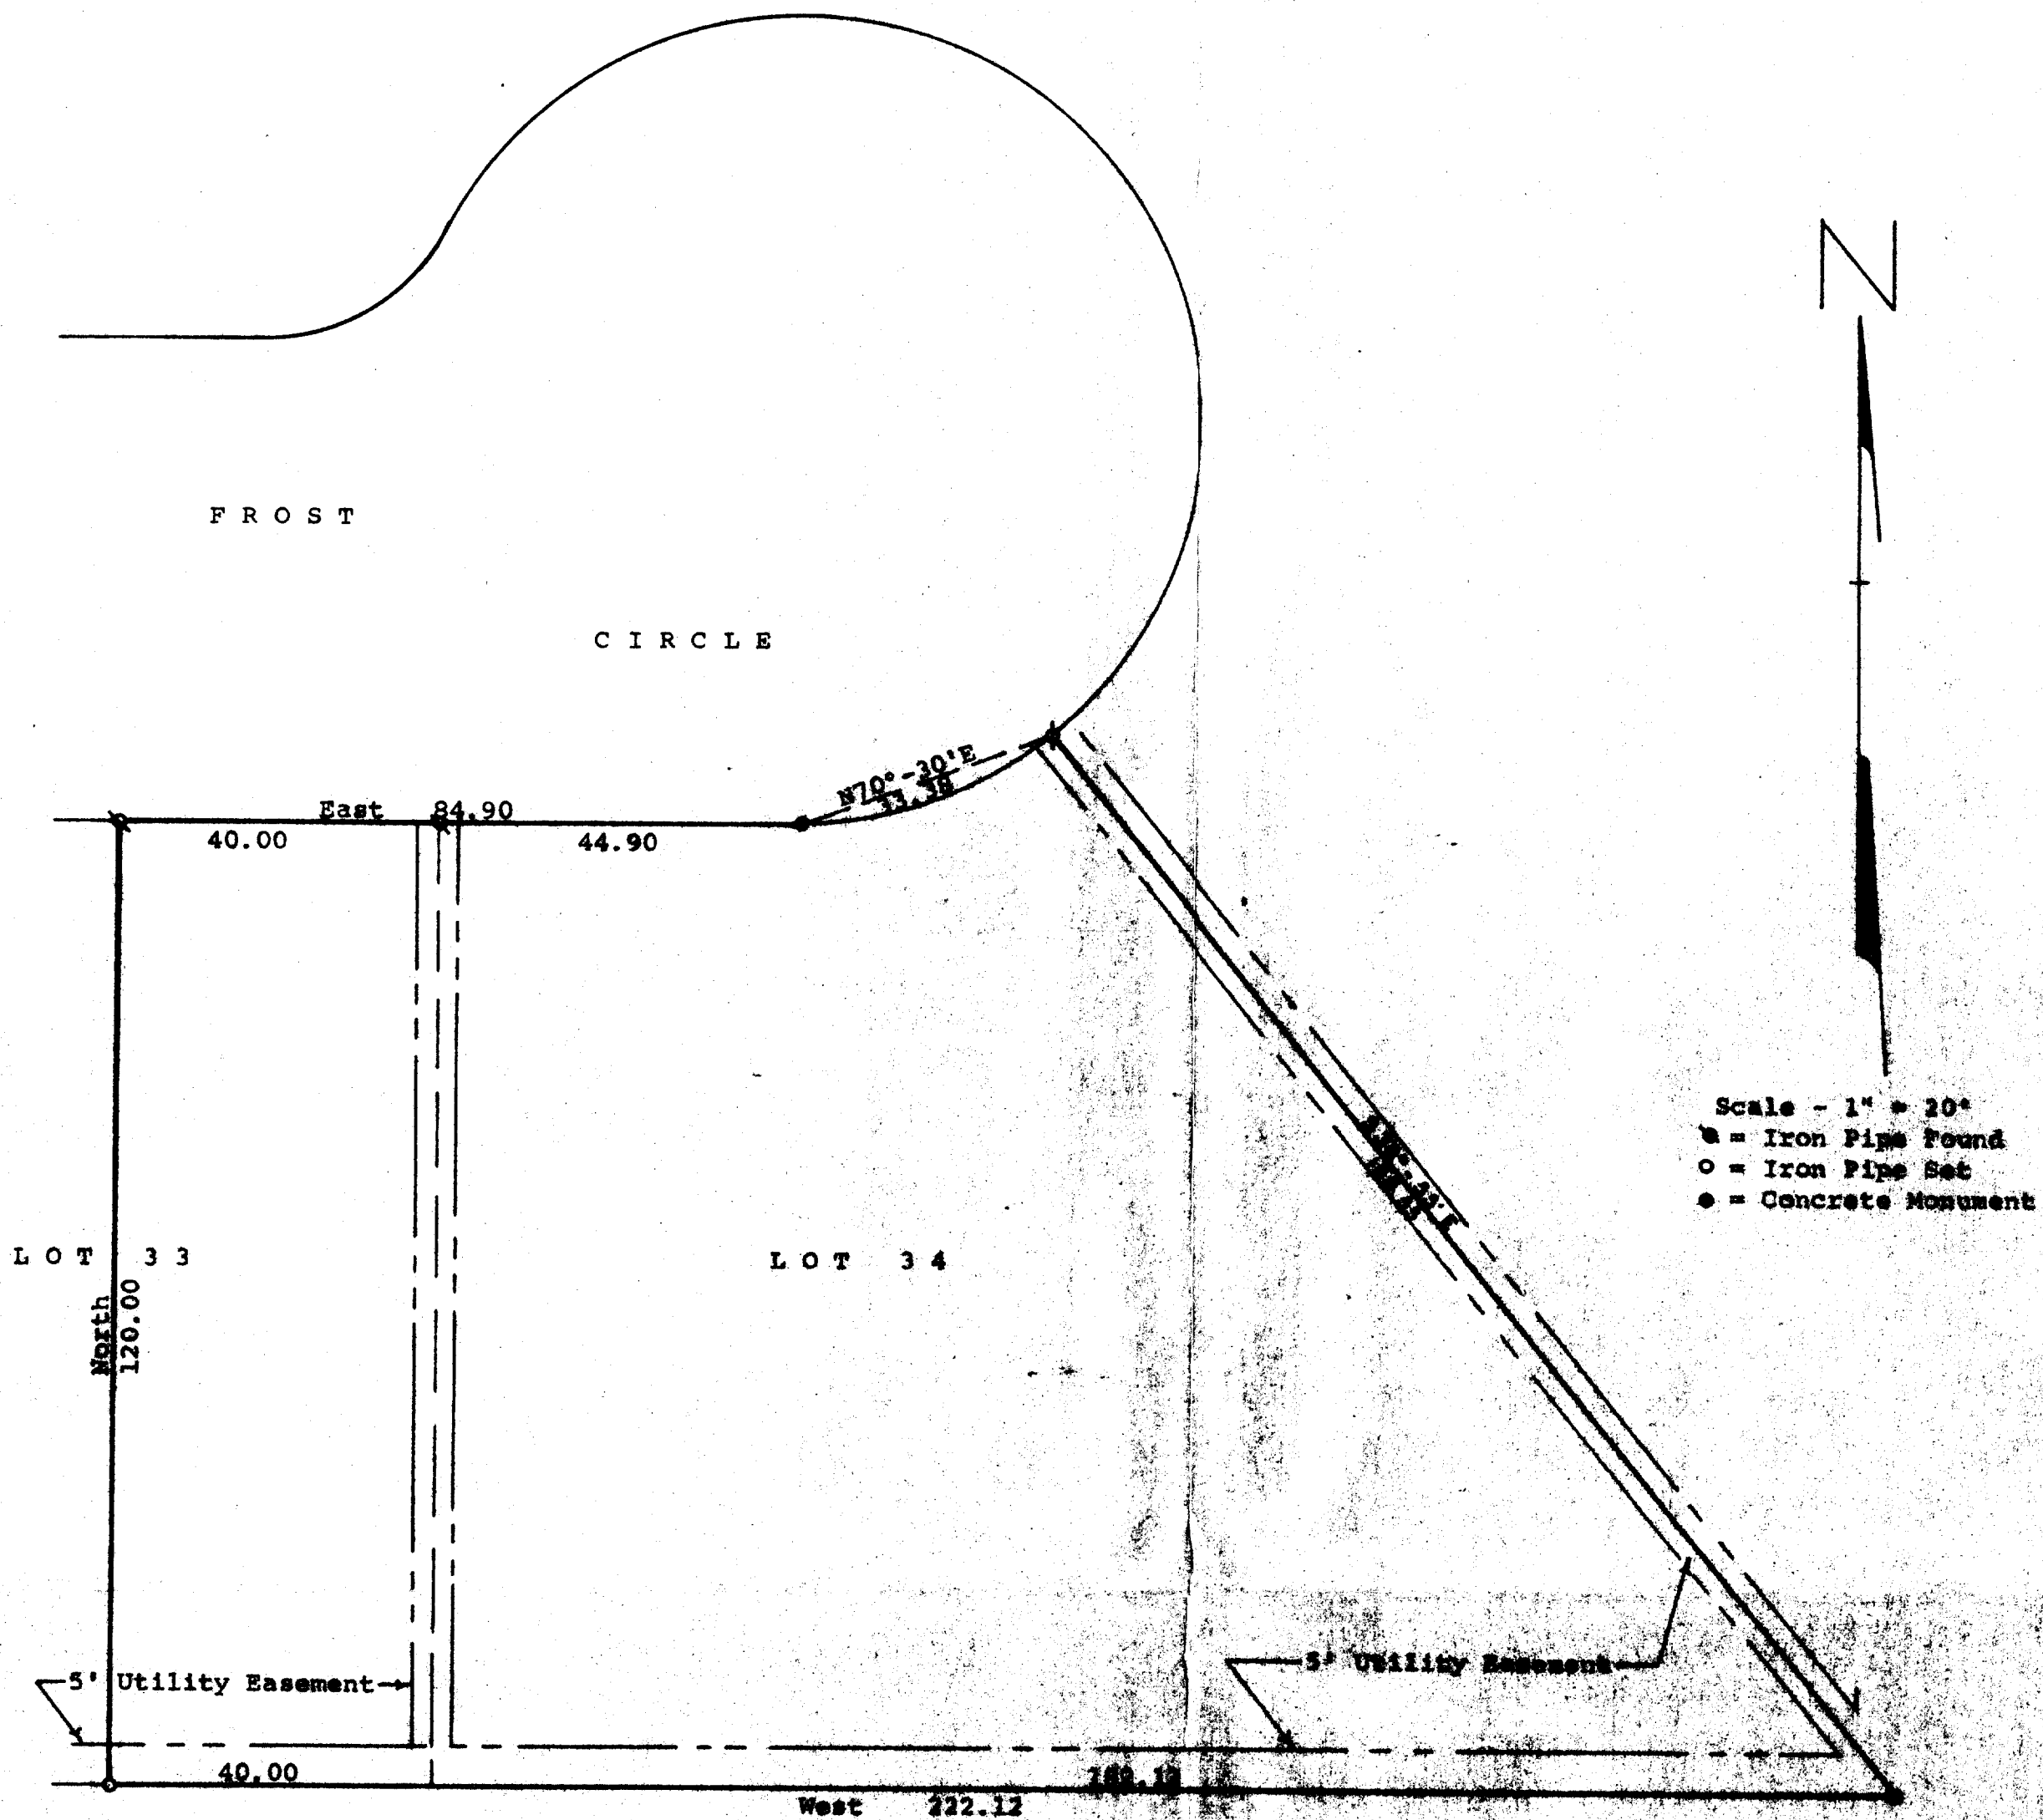

STATE OF WISCONSIN
COUNTY OF DELAVER

I, George F. Dunham, Surveyor, certify that I have surveyed and properly located the following:

Lot 33 and Lot 34, as shown by map of Lot 33 of Frost Circle Addition, Block 1, in the City of DelaVer, Wisconsin, and the shown map is a true and correct copy of the original map and the location of the property, the boundaries, the location and location of all structures, easements, and other encroachments, if any.

This survey is made for the purpose of the present record of the property and also for the purpose of showing the location of the Frost Circle Addition one (1) year from the date of the survey and map.

June 7, 1977

George F. Dunham
George F. Dunham, Surveyor