


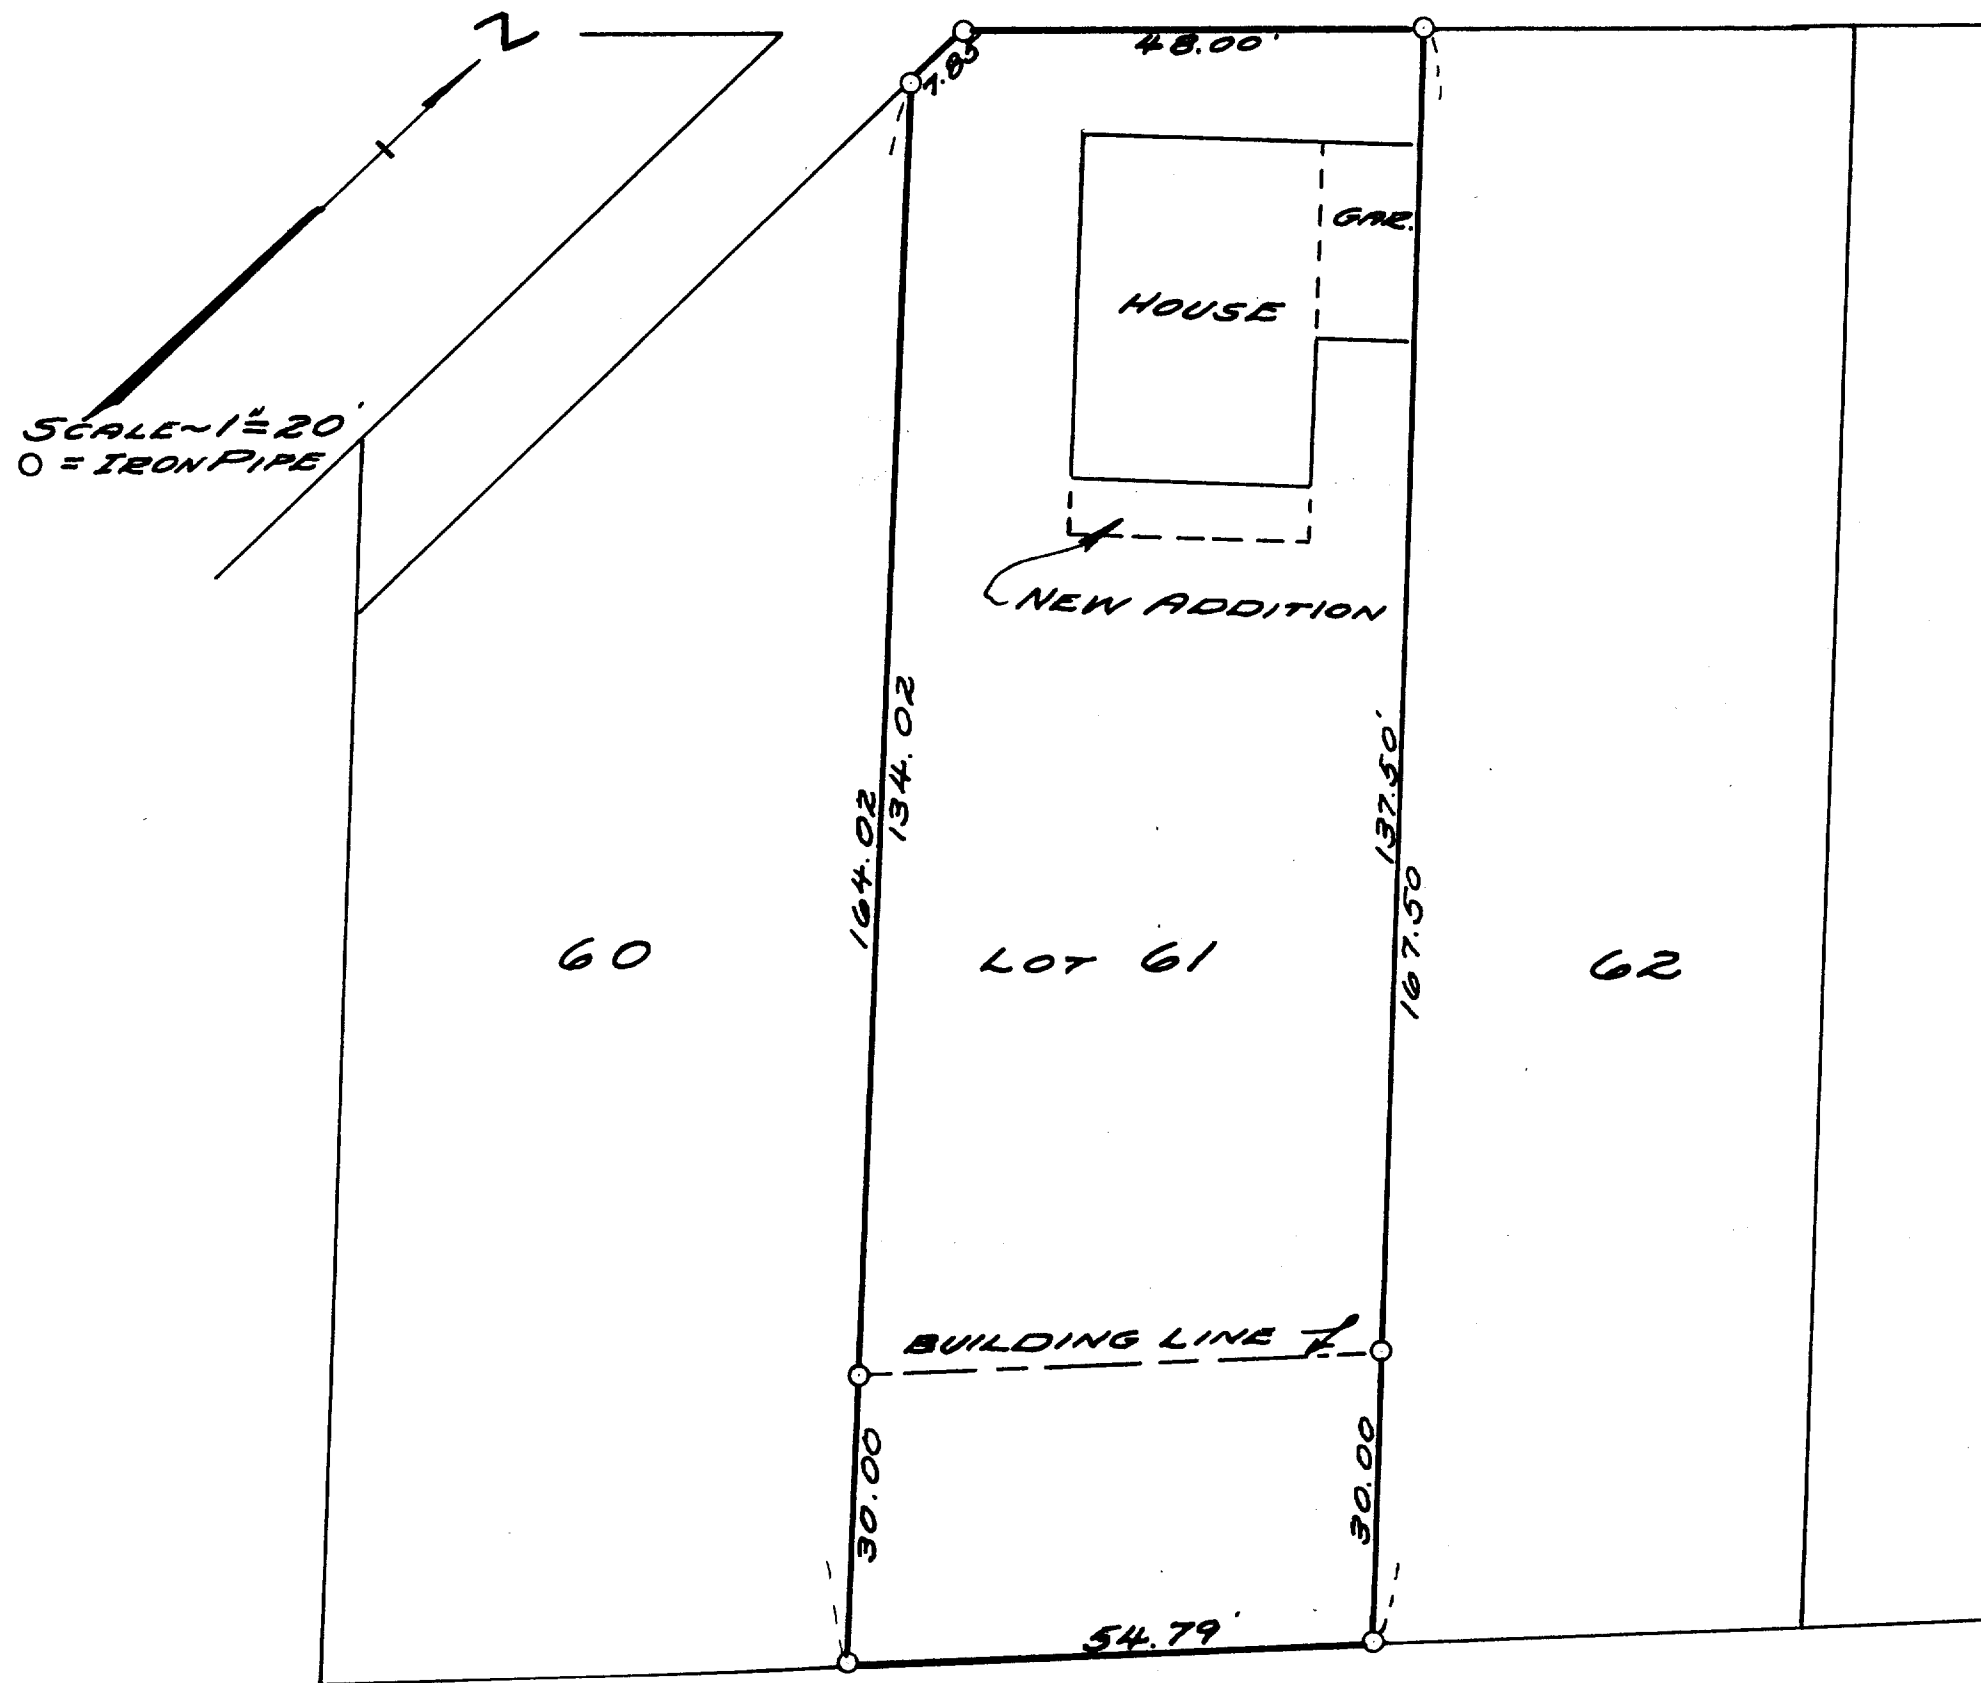

I HEREBY CERTIFY THAT I HAVE SURVEYED LOT 61 OF THE ORIGINAL CEDAR POINT PARK SUBDIVISION IN THE VILLAGE OF WILLIAMS BAY, WISCONSIN AND THAT THE ABOVE PLAT IS A CORRECT REPRESENTATION THEREOF. I FURTHER CERTIFY THAT I HAVE LOCATED THE BUILDING LINE AS SHOWN IN THE DEED FOR SAID LOT 61

DEC. 20, 1947

H. E. Johnson
SURVEYOR
R.C.E. 2093