


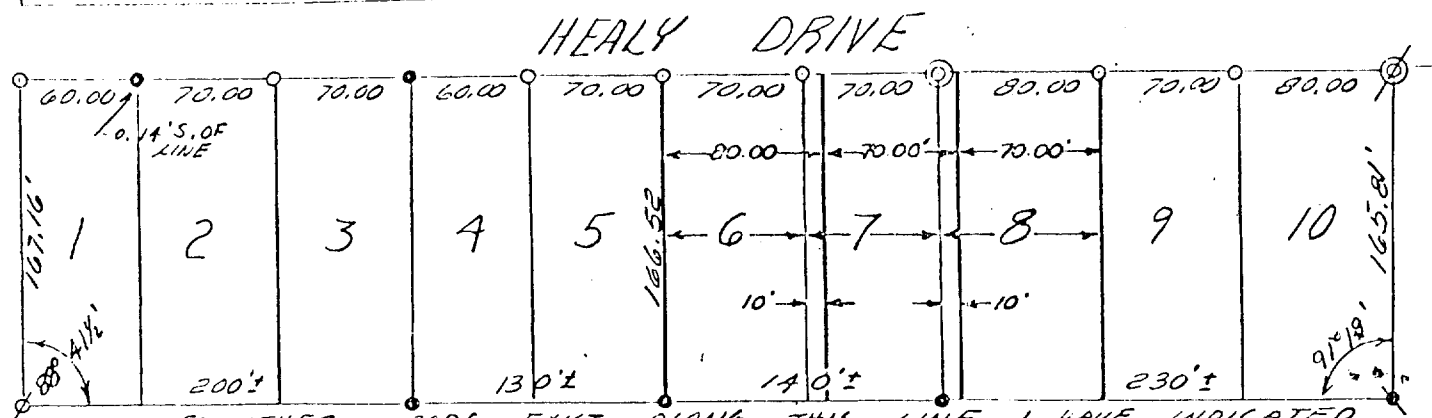

NOTE: OTHER RODS EXIST ALONG THIS LINE, I HAVE INDICATED ONLY THOSE MONUMENTS TO WHICH I MADE MEASUREMENTS

Legend For Metal Monuments

- = SET IRON PIPE 1" O.D. X 24" LONG
- = FOUND ORIGINAL 3/4" IRON ROD (Re Bar)
- ⊕ = FOUND ORIGINAL 1 1/2" IRON PIPE
- ⊙ = FOUND ORIGINAL 1 1/4" IRON ROD (Re Bar)
- ⊗ = RESET ORIGINAL 3/4" IRON ROD (Re Bar) FOUND LYING NEARBY
- ⊛ = RESET ORIGINAL 1 1/4" IRON ROD (Re Bar) FOUND LYING NEARBY


Relocation of the Northerly Line of Lot Corners
for Glennwood Estates, Village of Williams Bay,
Walworth County, Wisconsin

WORK ORDERED: REPLACE LOT CORNERS ON HEALY DRIVE WHICH HAD BEEN TORN UP DURING THE CONSTRUCTION OF WATERMAIN & STREET GRADING.

WORK ORDERED BY: GLENN ROOS

I HEREBY CERTIFY THAT I HAVE MADE THIS SURVEY AND PLACED THE MONUMENTS INDICATED AND THAT THIS PLAT IS A TRUE AND ACCURATE REPRESENTATION OF SAID SURVEY TO THE BEST OF MY PROFESSIONAL KNOWLEDGE & BELIEF.

DATED THIS 21st DAY of May 1979

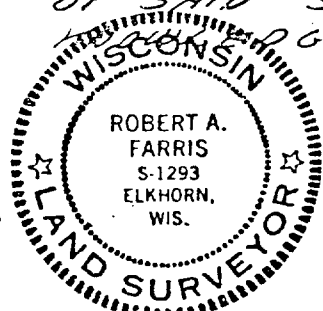

Robert A. Farris

REV. 24 MAY 1979

DRAWING NUMBER

1516

WGE-MISC
WGE-6
WGE-7

WGE-8

11-400-F