
KOLB LAND CONSULTING, INC.

LAND SURVEYING . SUBDIVIDING . LAND PLANNING

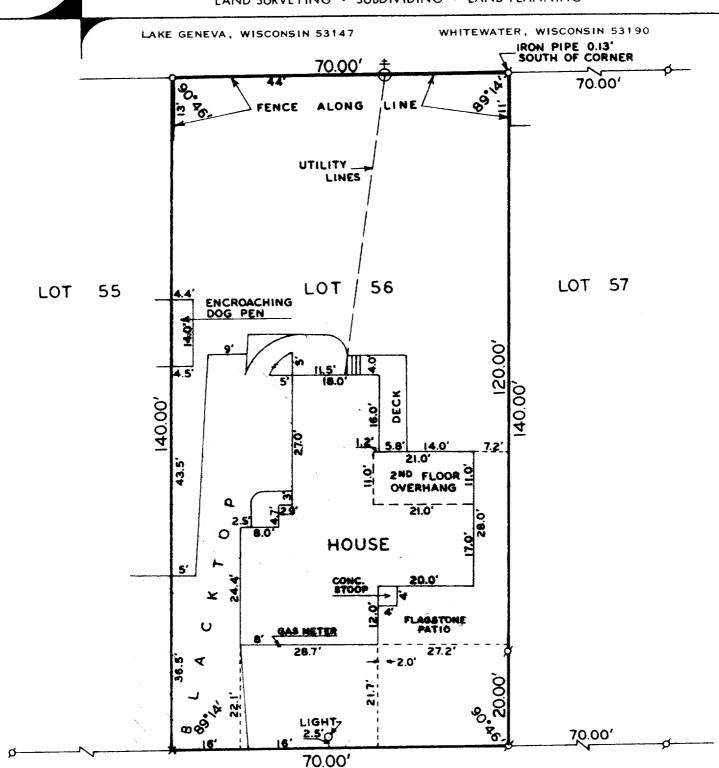

LACKEY

DRIVE

25' WIDE

ORDERED BY:

MARY MEYERS BOB KEEFE & ASSOCIATES, INC. WALWORTH, WI 53184

PLAT OF SURVEY OF

LOT 56, LACKEY BROTHERS SUBDIVISION, VILLAGE OF WILLIAMS BAY, WALWORTH COUNTY, WISCONSIN.



p- IRON PIPE FOUND

O- IRON PIPE SET

×- NAIL SET IN BLACKTOP



I HEREBY CERTIFY THAT I HAVE SURVEYED THE ABOVE DESCRIBED PROPERTY AND THAT THE ABOVE MAP IS A TRUE REPRESENTATION THEREOF AND SHOWS THE SIZE AND LOCATION OF THE PROPERTY, ITS EXTERIOR BOUNDARIES, THE LOCATION OF ALL VISIBLE STRUCTURES AND DIMENSIONS OF ALL PRINCIPAL BUILDINGS THEREON, BOUNDARY FENCES, APPARENT EASEMENTS, ROADWAYS AND VISIBLE ENCROACHMENTS, IF ANY.

THIS SURVEY IS MADE FOR THE USE OF THE PRESENT OWNERS OF THE PROPERTY, AND ALSO THOSE WHO PURCHASE, MORTGAGE, OR GUARANTEE THE TITLE THERETO WITHIN ONE (1) YEAR FROM DATE HEREOF.

Harrld H. Hell

HAROLD H. KOLB WISCONSIN REGISTERED LAND SURVEYOR, S-187

DATE JUNE, 7, 1979