


HAROLD H. KOLB

REGISTERED PROFESSIONAL LAND SURVEYOR
LAKE GENEVA, WISCONSIN

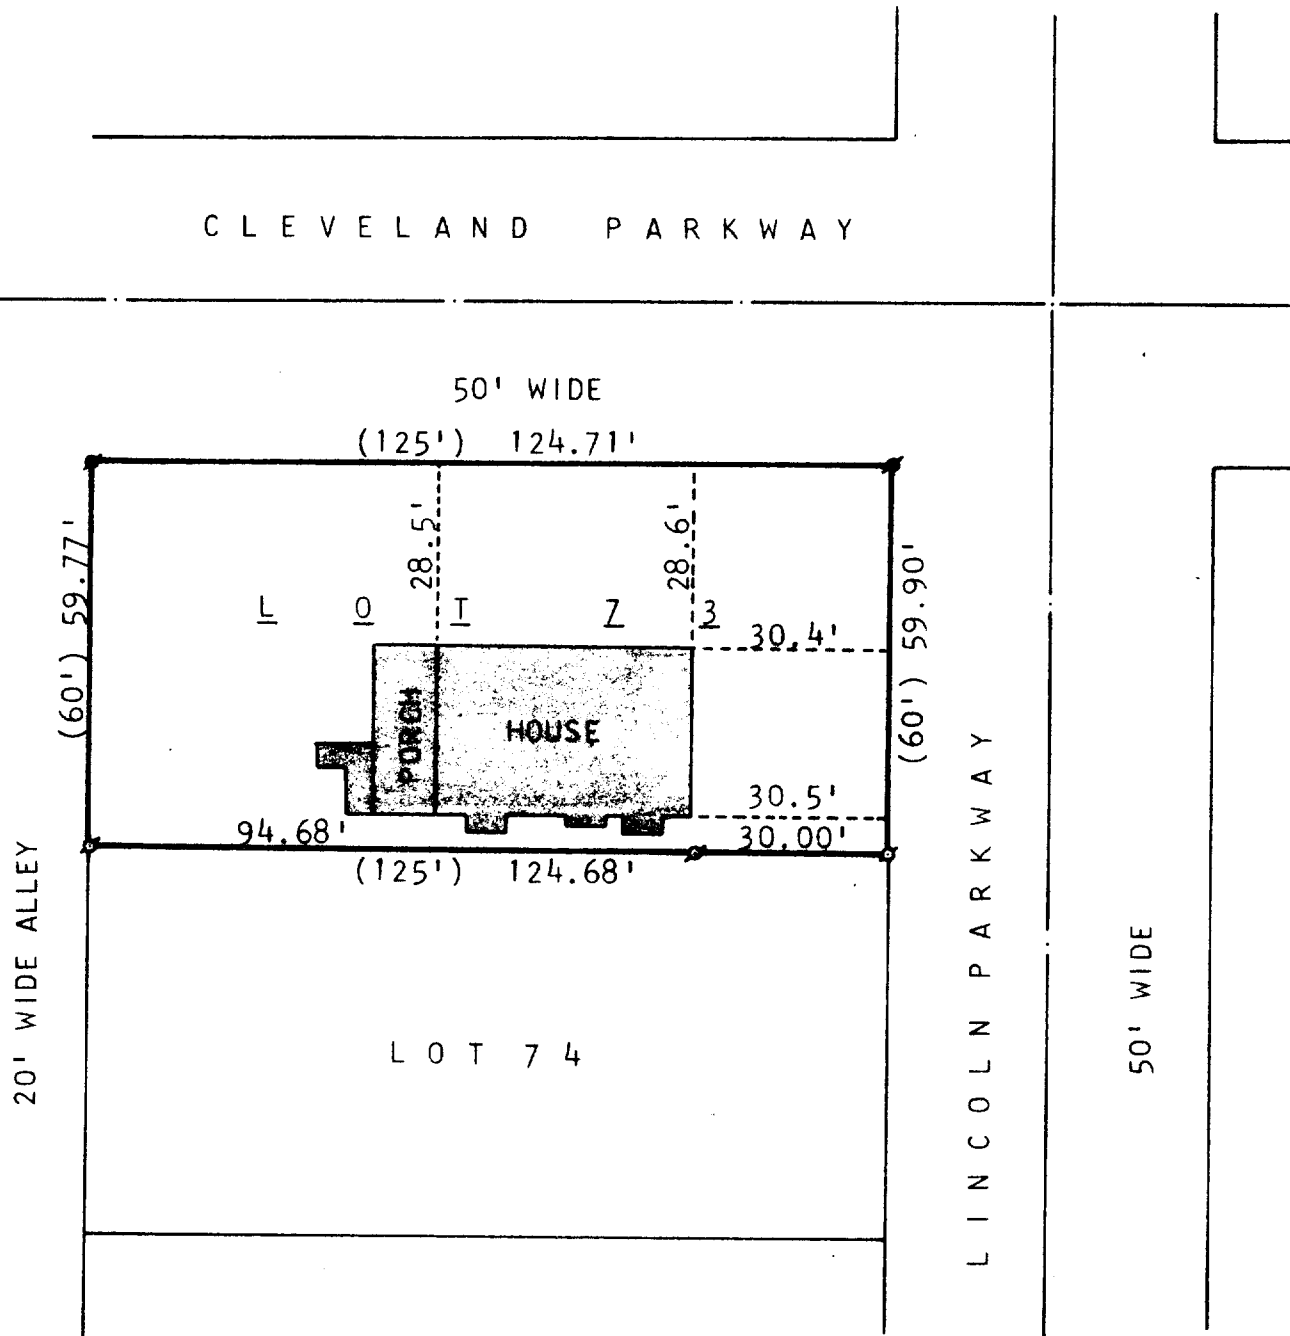

PLAT OF SURVEY OF

LOT 73 OF THE ORIGINAL PLAT OF CEDAR POINT PARK,
A SUBDIVISION LOCATED IN THE VILLAGE OF WILLIAMS
BAY, WALWORTH COUNTY, WISCONSIN.

ORDERED BY: HOTTON REALTY
60 W. GENEVA STREET
WILLIAMS BAY, WIS.



SCALE: 1"=30'

LEGEND

- O — IRON PIPE PLACED, 1" x 24" 1.13 LB./LIN. FT.
- — CONCRETE MONUMENT, 5" DIA. x 30" FOUND
- σ — IRON PIPE FOUND () — AS PLATTED

Harold H. Kolb
HAROLD H. KOLB
WISCONSIN REGISTERED LAND SURVEYOR, S-187
DATE Oct. 3, 1978