


WILMETTE

ROAD

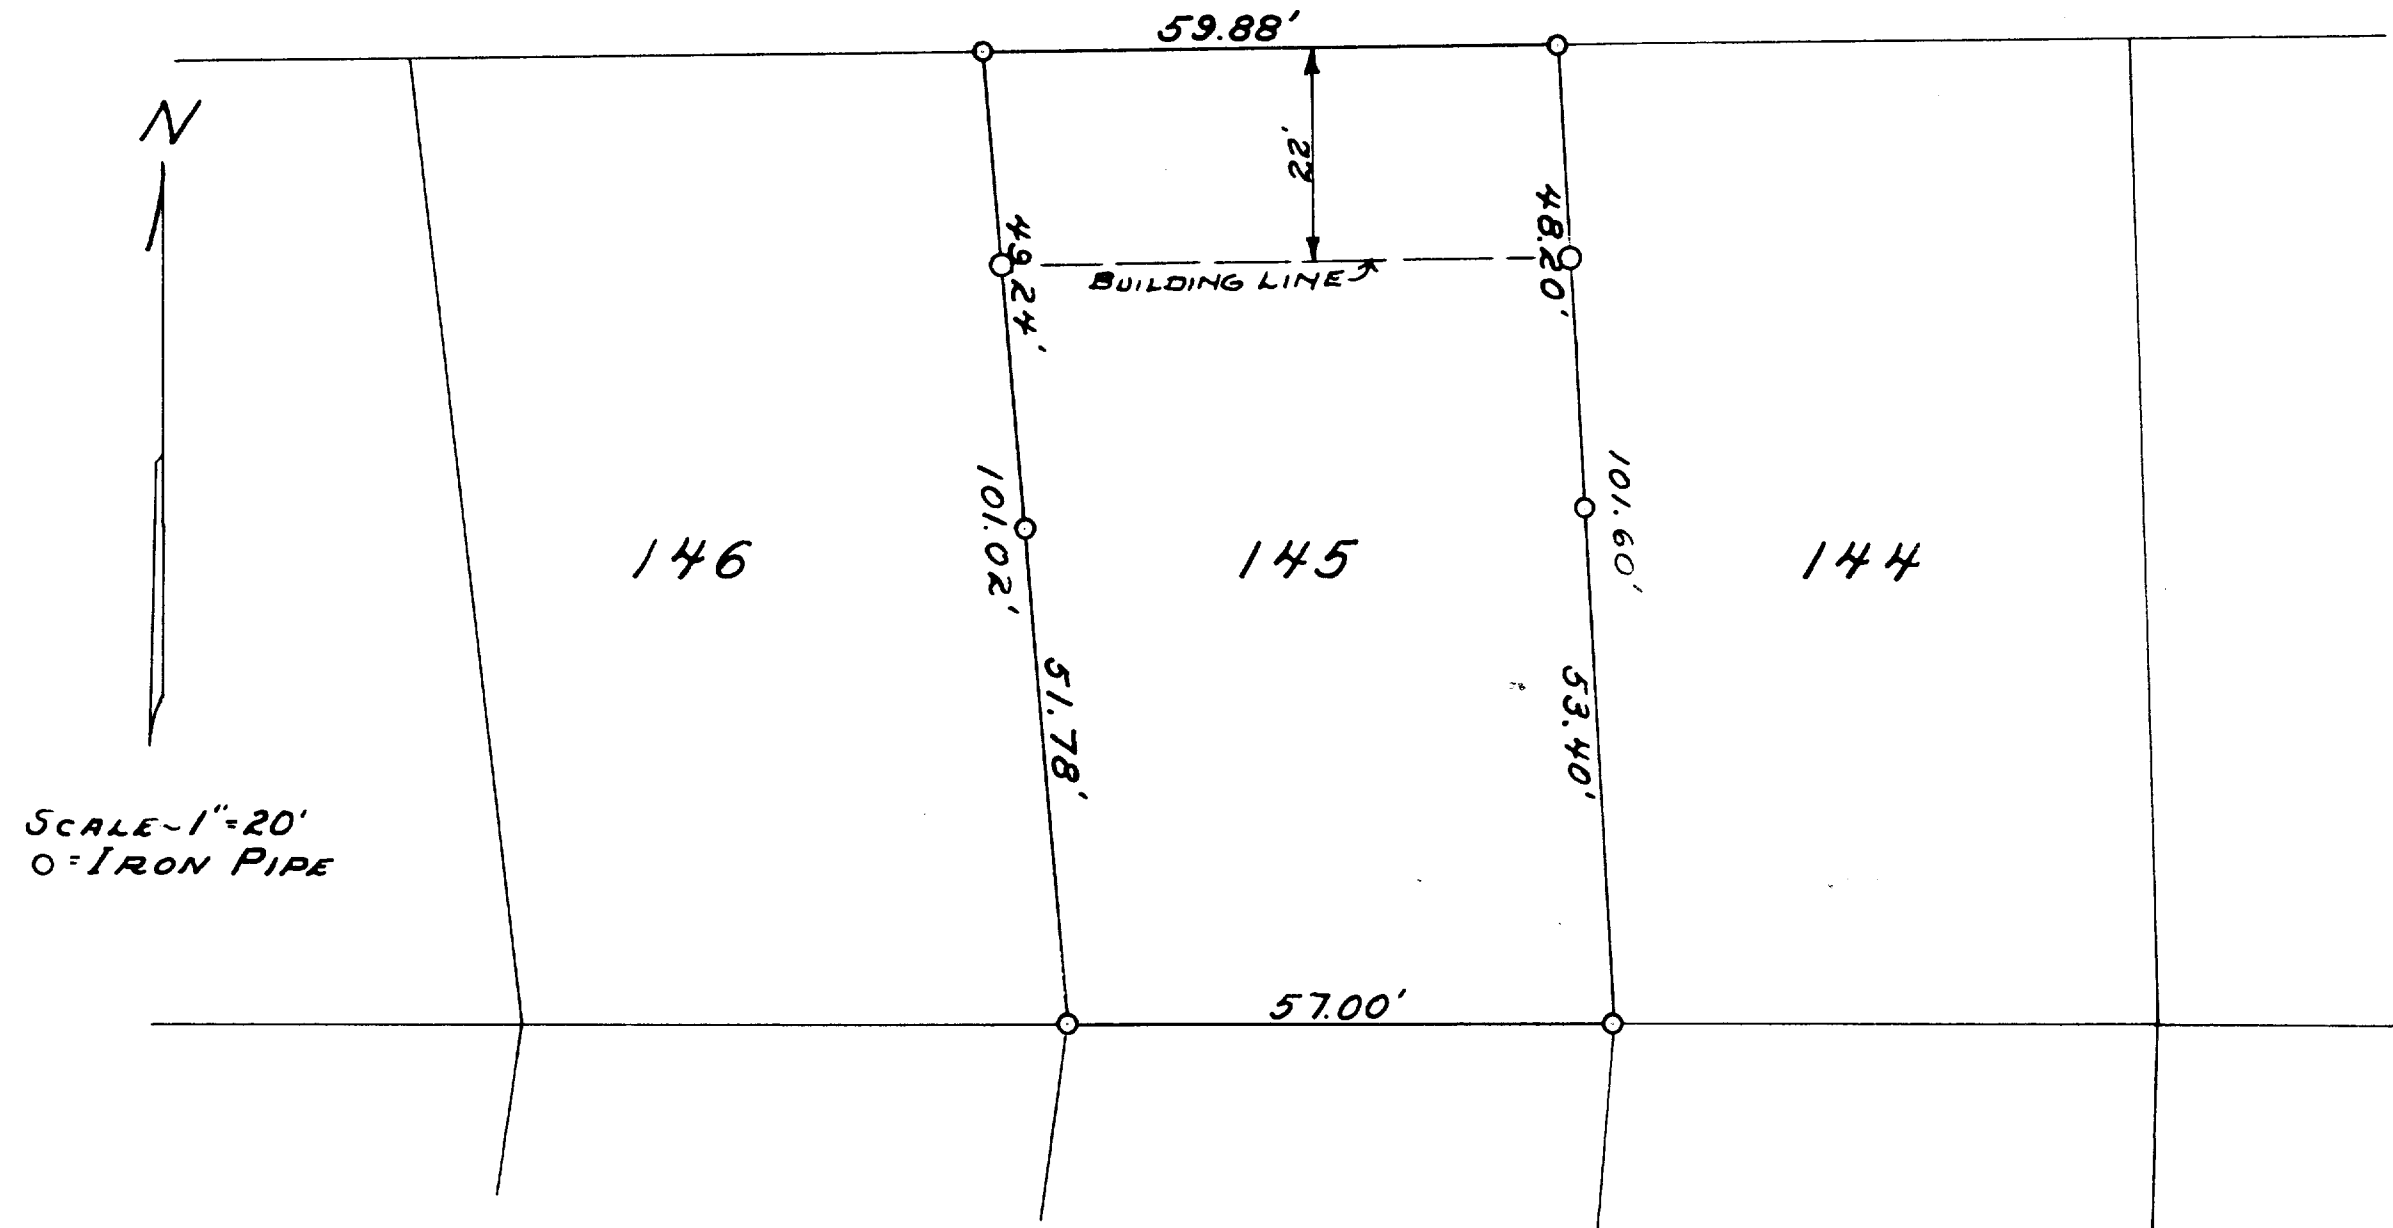

PLAT OF SURVEY OF LOT 145 OF THE 2ND
ADDITION TO CEDAR POINT PARK LOCATED IN
THE VILLAGE OF WILLIAMS BAY, WALWORTH
COUNTY, WISCONSIN.
SEPT. 1948

WCP2-41

Lloyd L. Jensen
SURVEYOR

11-40