


DUNHAM SURVEYING, S.C.
SURVEYING & SUBDIVIDING
DELAVAN, WISCONSIN 53115

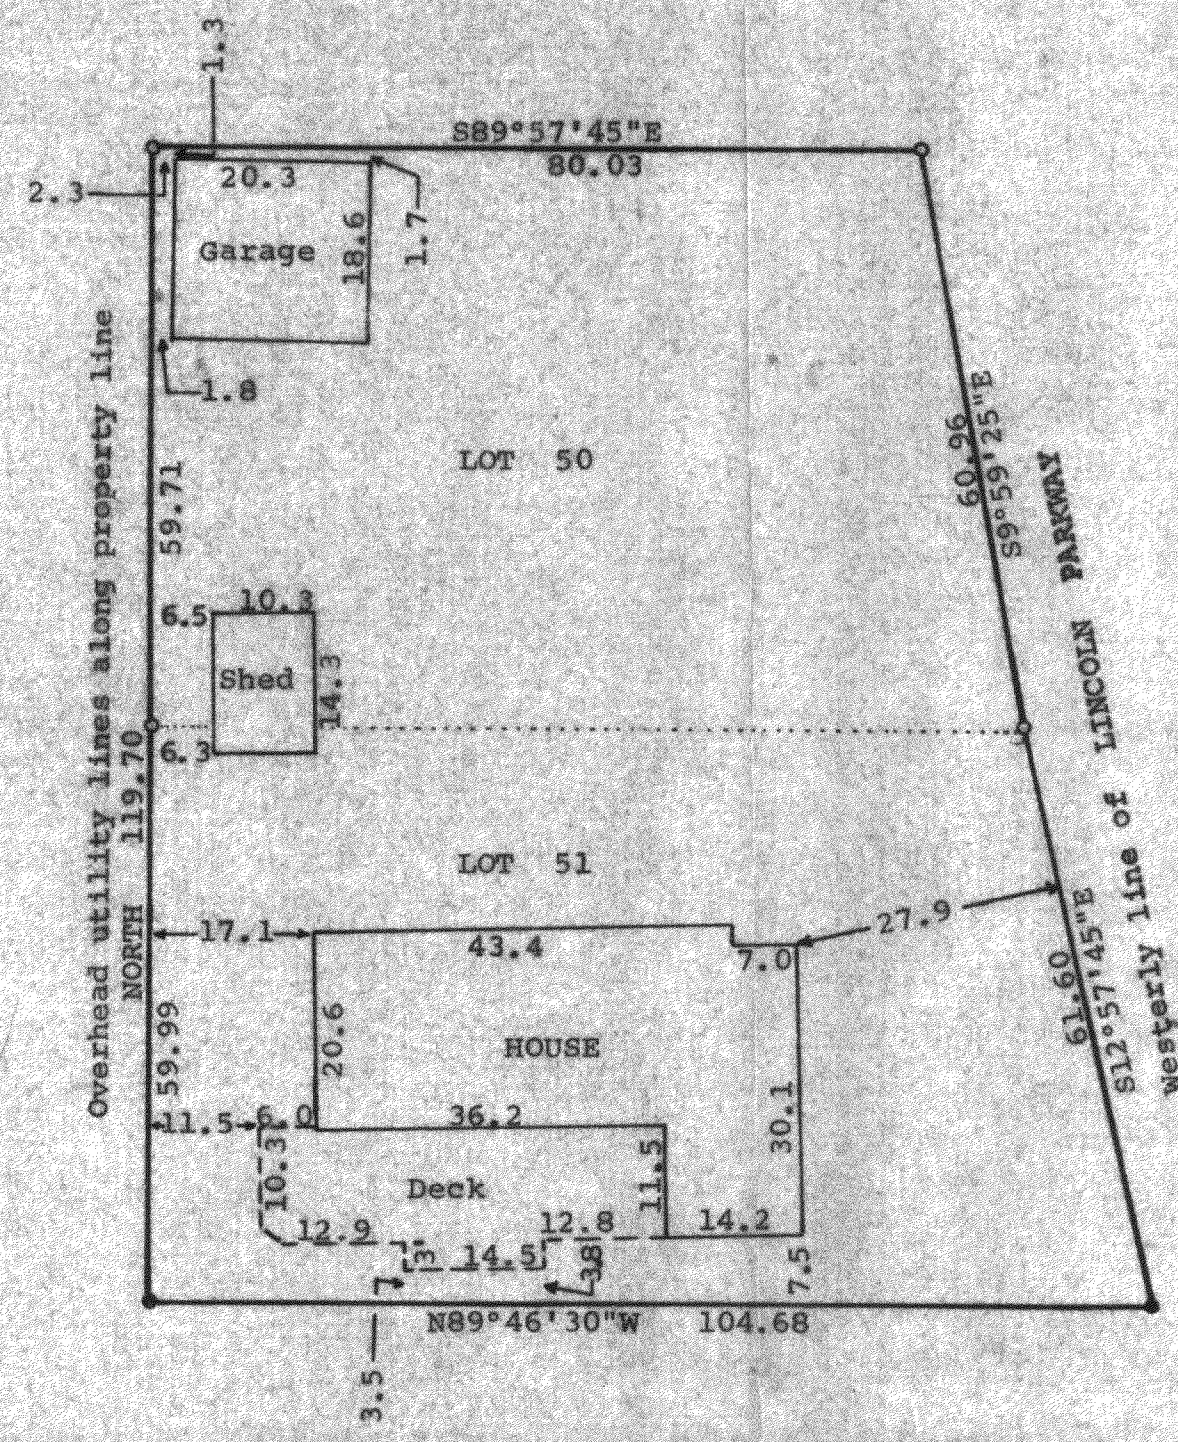

Scale - 1" = 20'
• = Iron Rod Found
o = Iron Pipe Found
Bearings referenced to the west line
of Lots 50 and 51 with the assumed
bearing of North
Owner: Dr. Joseph Nigro
609 Frazier Ct.
Wheaton, ILL 60187

STATE OF WISCONSIN)
COUNTY OF WALWORTH) SS

I, George T. Dunham, Surveyor, certify that I have surveyed
the property described as follows,
Lots 50 and 51 of Cedar Point Park, a subdivision located in
the Village of Williams Bay, Walworth County, Wisconsin,
and that the above map is a true representation thereof and shows the
size and location of the property, its exterior boundaries, the location
of all visible structures and dimensions of all principal buildings
thereon, boundary fences, apparent easements, roadways and visible
encroachments, if any.
This survey is made for the use of the present owners of the property,
and also those who purchase, mortgage, or guarantee the title thereto
within one (1) year from date hereof.
December 17, 1981

George T. Dunham
George T. Dunham, Surveyor

