


KOLB LAND CONSULTING, INC.
LAND SURVEYING • SUBDIVIDING • LAND PLANNING

LAKE GENEVA, WISCONSIN 53147

WHITEWATER, WISCONSIN 53190

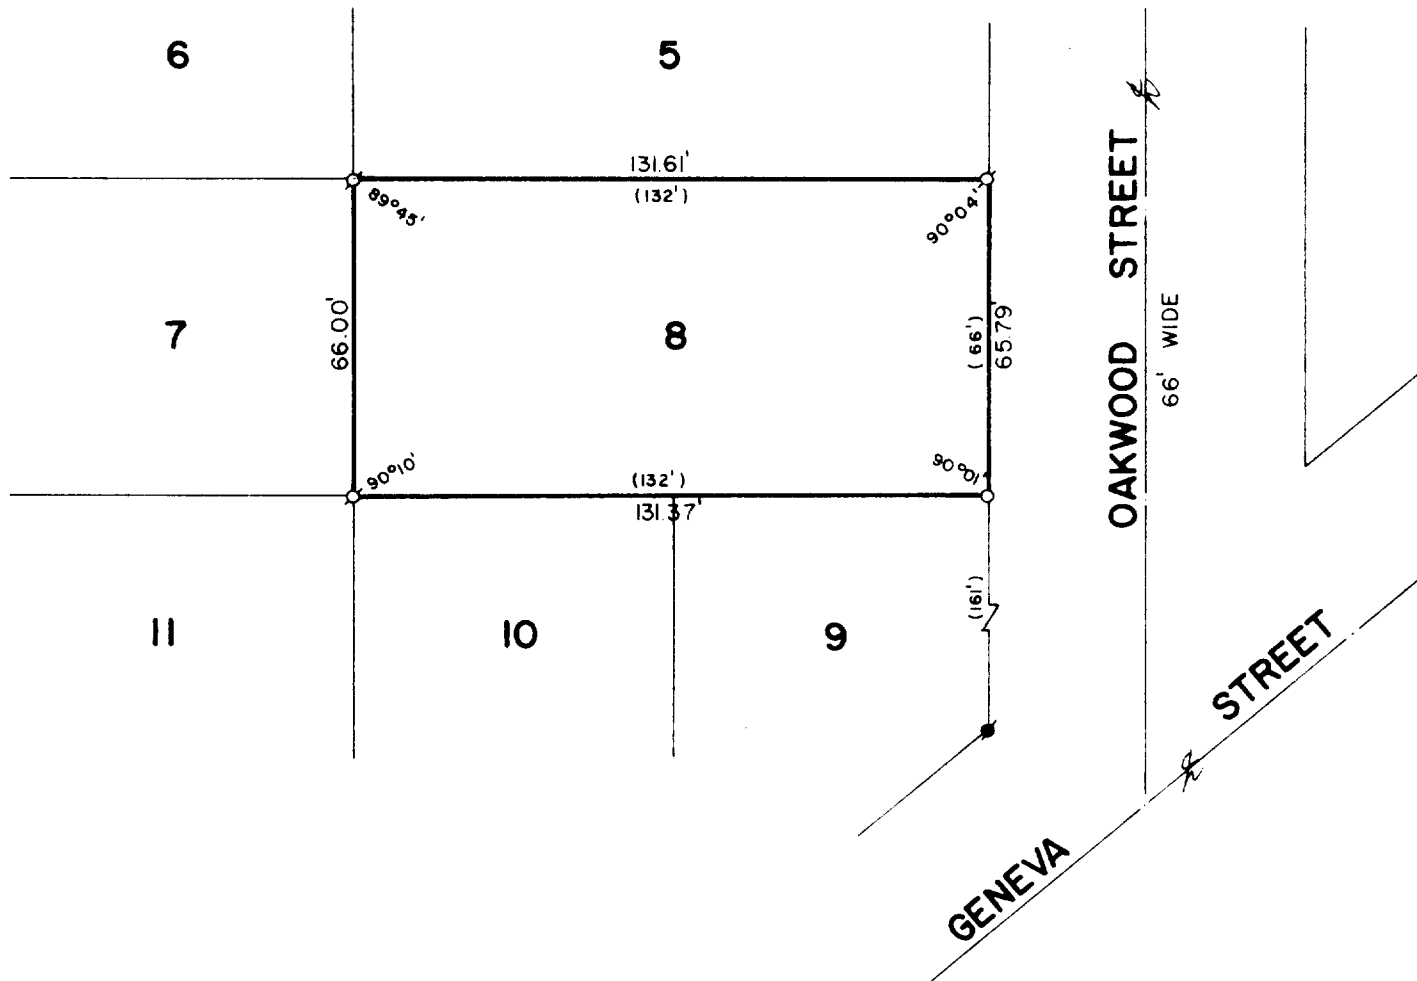


PLAT OF SURVEY OF

BLK 17

LOT 8 OF WILLIAMS 2ND ADDITION TO THE VILLAGE OF WILLIAMS BAY, T 1 N, R 16 E, WALWORTH COUNTY, WISCONSIN.

ORDERED BY: VICTOR L. PAGEL
28 OAKWOOD STREET
WILLIAMS BAY, WISCONSIN 53191

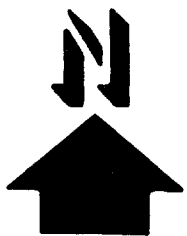

SCALE • 1"=40'

- - IRON PIPE PLACED
- ⊙ - IRON PIPE FOUND
- - CONCRETE MONUMENT FOUND
- () - RECORDED AS

I, HAROLD H. KOLB, DO HEREBY CERTIFY
THAT I HAVE SURVEYED THE PROPERTY
HEREON DESCRIBED ACCORDING TO THE
OFFICIAL RECORDS, AND THAT THE PLAT
HEREON IS A CORRECT REPRESENTATION
OF THE LOT LINES TO THE BEST OF MY
KNOWLEDGE AND BELIEF.

Harold H. Kolb

HAROLD H. KOLB
WISCONSIN REGISTERED LAND SURVEYOR, S-197

DATE Nov. 2, 1981