


ENGINEERING, SURVEYING AND LAND PLANNING
715 W. WALWORTH ST. - P.O. BOX 487 - ELKHORN, WI 53121
OFFICE: 414/723-2088

Buyer: John J. & Rosara E. Markett




NORTH
Scale: 1"=30'

⚡ = Iron pipe survey stake found
 ○ = Iron pipe survey stake placed
 △ = Concrete (P.K.) nail found
 (xx) = Record dimension from original plat

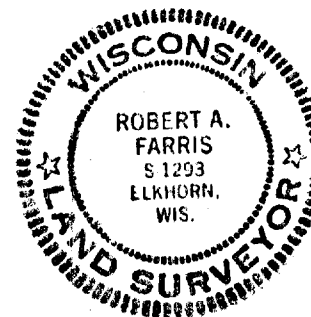

Privacy Fence Along Part of this
line is located entirely on lots 26 & 27

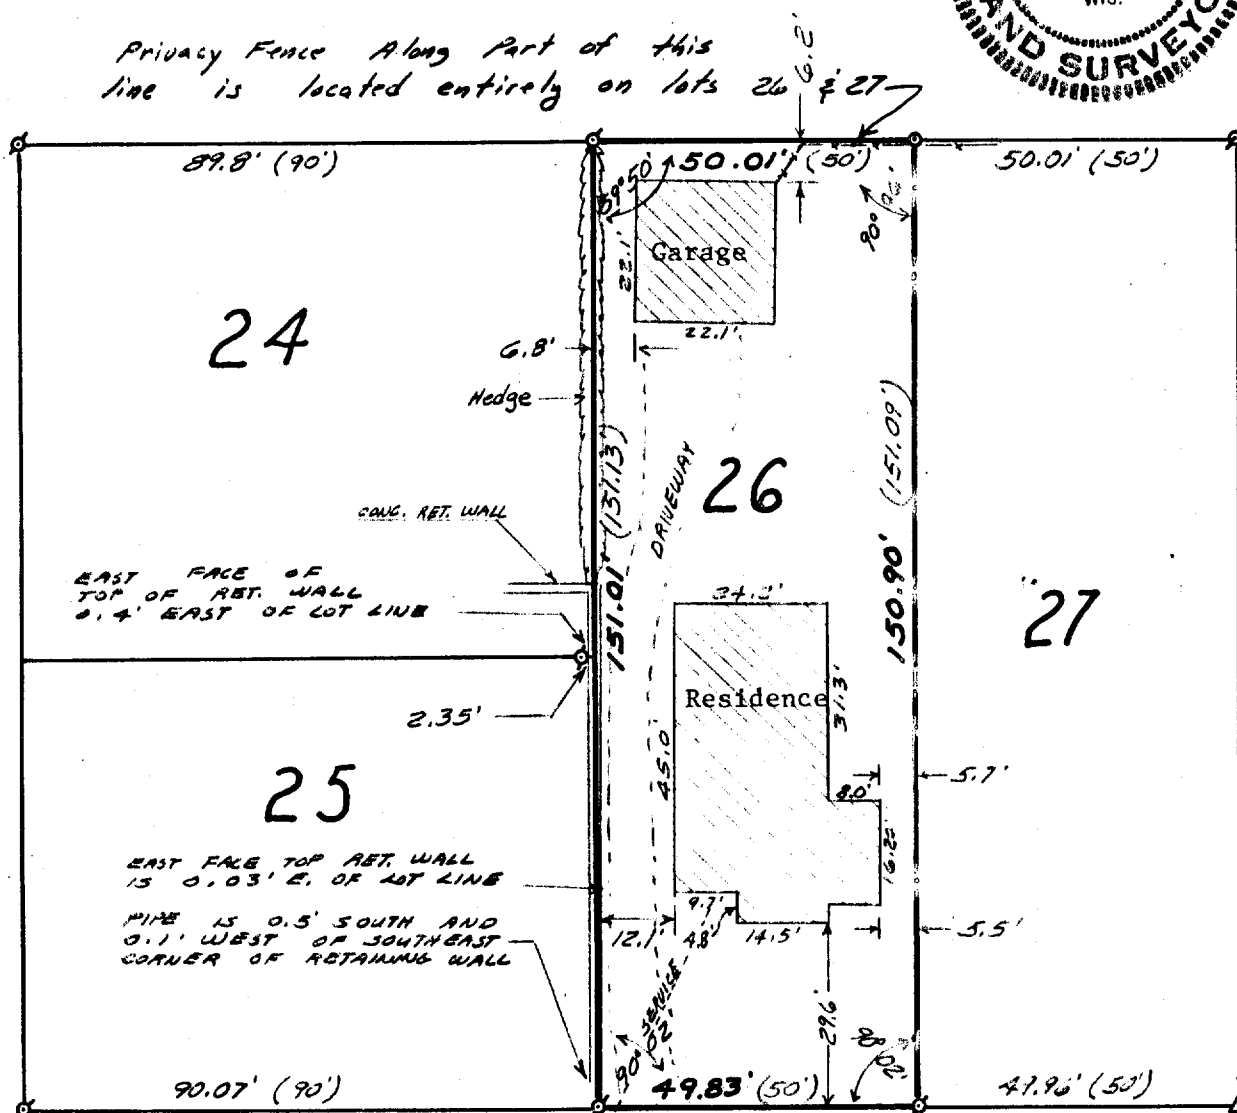

This survey is made for the use of the present owners of the property, and also those who purchase, mortgage, or guarantee the title thereto within one (1) year from date hereof.

LEICHTY DRIVE 30' WIDE

Robert A. Harris 6 Nov. 1981

DRAWING NUMBER #1904