


KOLB LAND CONSULTING, INC.
LAND SURVEYING • SUBDIVIDING • LAND PLANNING

LAKE GENEVA, WISCONSIN 53147

WHITEWATER, WISCONSIN 53190

ORDERED BY: GEORGE MOTZKO
354 N. FROST DR.
WILLIAMS BAY, WI

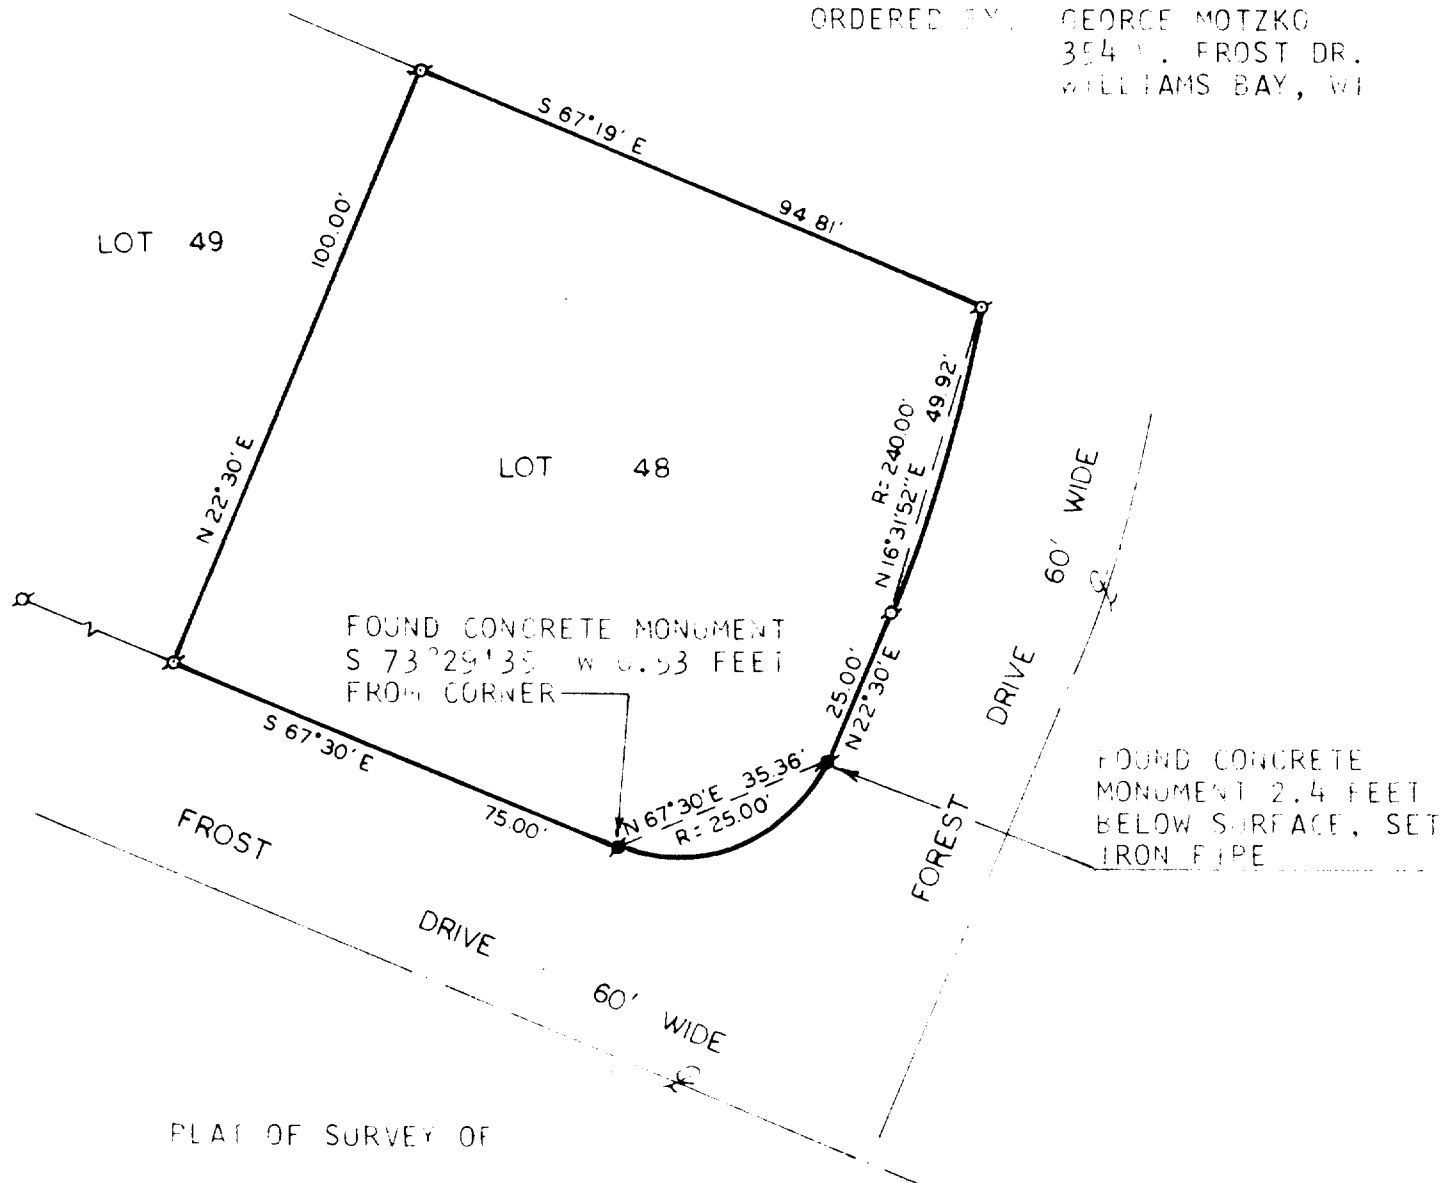

PLAT OF SURVEY OF

LOT 48 OF BAYWOOD HEIGHTS ADDITION
NO. 1, VILLAGE OF WILLIAMS BAY,
WATWORTH COUNTY, WISCONSIN.

NOTE: BEARINGS TAKEN FROM SUBDIVISION PLAT OF
BAYWOOD HEIGHTS ADDITION NO. 1.



SCALE 1" = 30'

LEGEND

- - IRON PIPE FOUND
- - CONCRETE MONUMENT FOUND

I, HAROLD H. KOLB, DO HEREBY CERTIFY
THAT I HAVE SURVEYED THE PROPERTY
HEREON DESCRIBED ACCORDING TO THE
OFFICIAL RECORDS, AND THAT THE PLAT
HEREON IS A CORRECT REPRESENTATION
OF THE LOT LINES TO THE BEST OF MY
KNOWLEDGE AND BELIEF.

Harold H. Kolb
HAROLD H. KOLB
WISCONSIN REGISTERED LAND SURVEYOR, S- 117
DATE Oct. 6, 1982