


KOLB LAND CONSULTING, INC.

LAND SURVEYING • SUBDIVIDING • LAND PLANNING

LAKE GENEVA, WISCONSIN 53147


WHITEWATER, WISCONSIN 53190

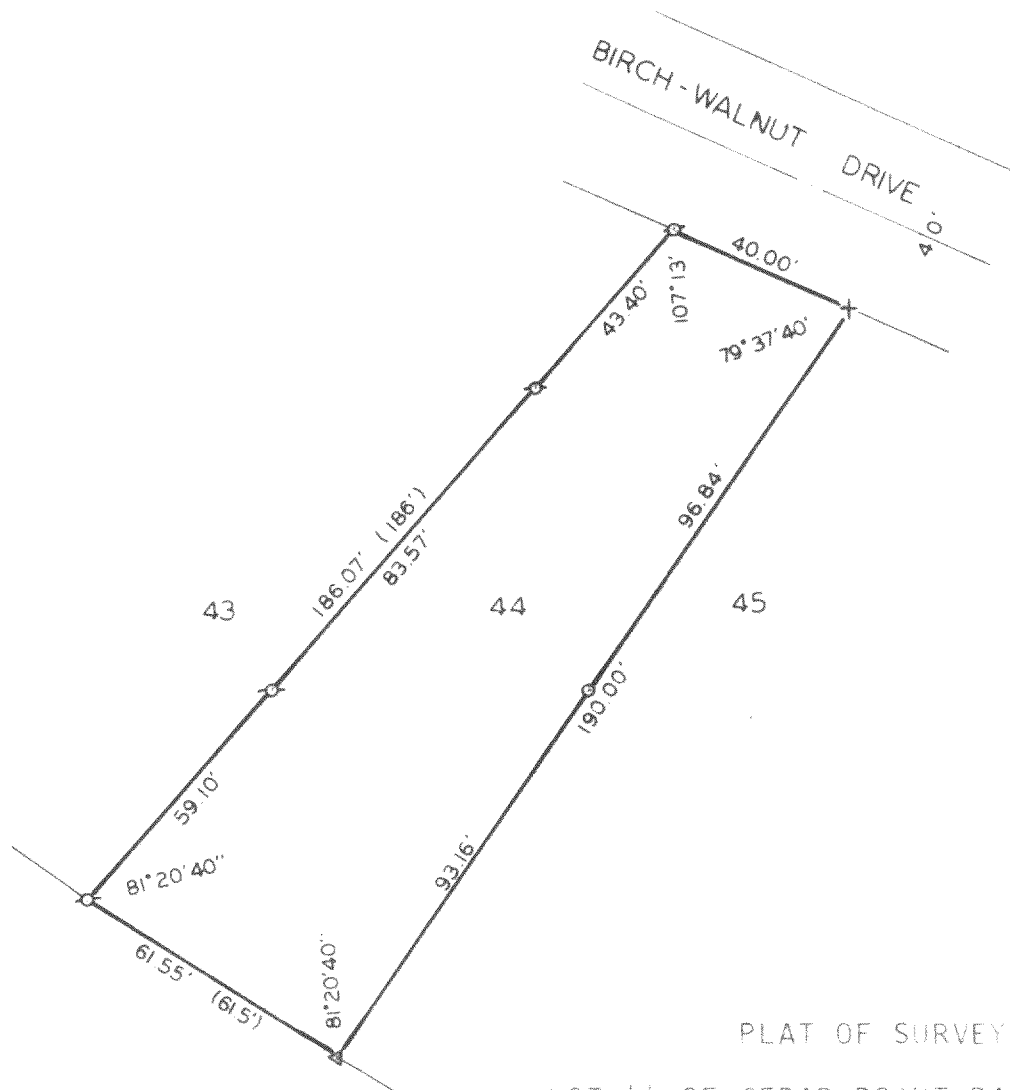

PLAT OF SURVEY OF

LOT 44 OF CEDAR POINT PARK FIRST ADDITION,
VILLAGE OF WILLIAMS BAY, WALWORTH COUNTY,
WISCONSIN.

ORDERED BY: BOB SHARPENTER
300 NORTH LAKE ST.
MONTGOMERY, IL 60538

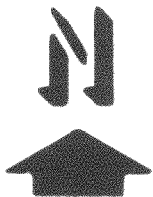

SCALE - 1"=40'

LEGEND

- - IRON PIPE FOUND
- △ - IRON ROD FOUND
- - IRON PIPE SET
- +
- () - CUT CROSS IN CONCRETE
- () - RECORDED AS

I, HAROLD H. KOLB, DO HEREBY CERTIFY
THAT I HAVE SURVEYED THE PROPERTY
HEREON DESCRIBED ACCORDING TO THE
OFFICIAL RECORDS, AND THAT THE PLAT
HEREON IS A CORRECT REPRESENTATION
OF THE LOT LINES TO THE BEST OF MY
KNOWLEDGE AND BELIEF.

Harold H. Kolb

HAROLD H. KOLB
WISCONSIN REGISTERED LAND SURVEYOR, S-187

DATE June 18, 1991