


WALWORTH COUNTY SURVEYING & MAPPING LAKE GENEVA, WISCONSIN

W. I




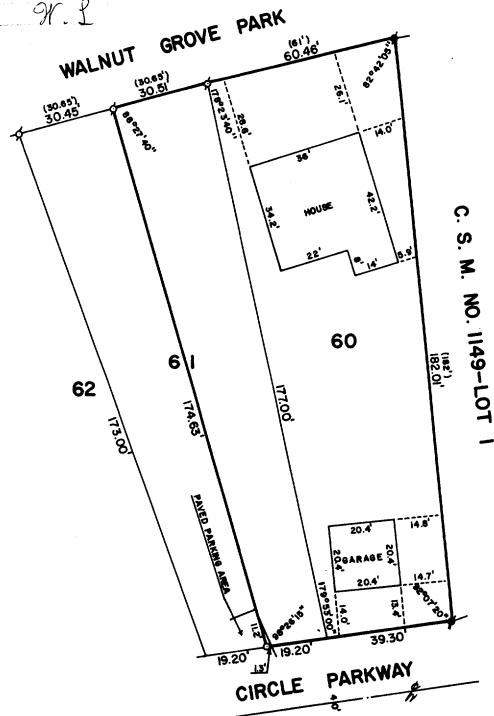

PLAT OF SURVEY OF

LOT 60 AND THE EAST 1/2 OF LOT 61 IN CEDAR POINT PARK 1ST ADDITION, LOCATED IN THE VILLAGE OF WILLIAMS BAY, WALWORTH COUNTY, WISCONSIN.

ORDERED BY: MARGARET ROTCHFORD CENTURY 21 FULL SERVICE REALTY 4044 N. LINCOLN AVENUE CHICAGO, ILLINOIS 60618

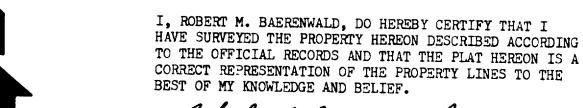

SCALE: 1"=30"

ø-IRON PIPE FOUND

▼ -CONCRETE MONUMENT FOUND

()-RECORDED AS

O -IRON PIPE PLACED

Robert M. Barunell

ROBERT M. BAERENWALD
WISCONSIN REGISTERED LAND SURVEYOR, S-1508

DATE