


WALWORTH COUNTY SURVEYING & MAPPING LAKE GENEVA, WISCONSIN

WILMETTE ROAD

40' WIDE

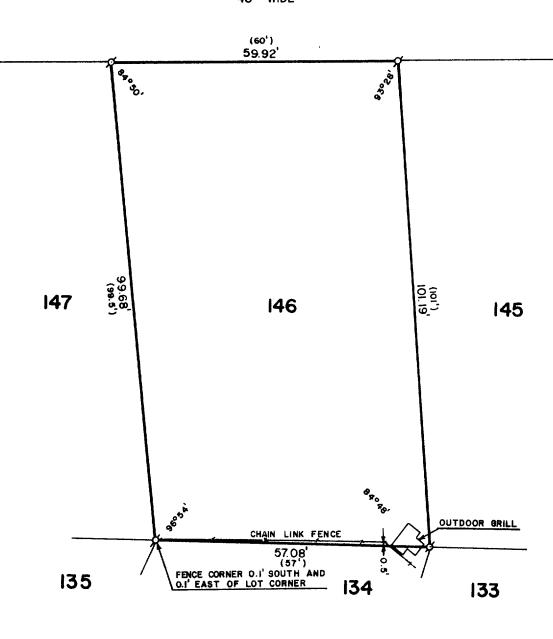


PLAT OF SURVEY OF

LOT 146 OF CEDAR POINT PARK 2ND ADDITION, T.1 N, R 17 E, VILLAGE OF WILLIAMS BAY, WALWORTH COUNTY, WISCONSIN.

ORDERED BY: KEEFE REAL ESTATE 704 MAIN STREET

LAKE GENEVA, WISCONSIN 53147

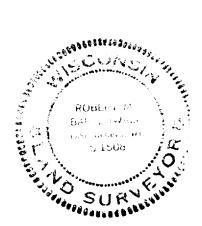



SCALE: 1"=20"

ø-IRON PIPE FOUND ()-RECORDED AS I, ROBERT M. BAERENWALD, DO HEREBY CERTIFY THAT I HAVE SURVEYED THE PROPERTY HEREON DESCRIBED ACCORDING TO THE OFFICIAL RECORDS AND THAT THE PLAT HEREON IS A CORRECT REPRESENTATION OF THE PROPERTY LINES TO THE BEST OF MY KNOWLEDGE AND BELIEF.

ROBERT M. BAERENWALD

WISCONSIN REGISTERED LAND SURVEYOR, S-1508

DATE July 28, 1984

JOB NO. 0097