



DUNHAM SURVEYING, S.C.
SURVEYING & SUBDIVIDING
DELAVAN, WISCONSIN 53115

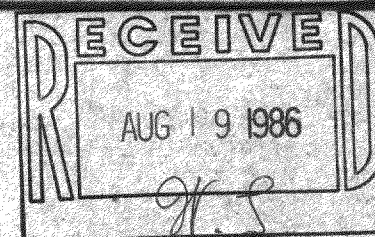

N

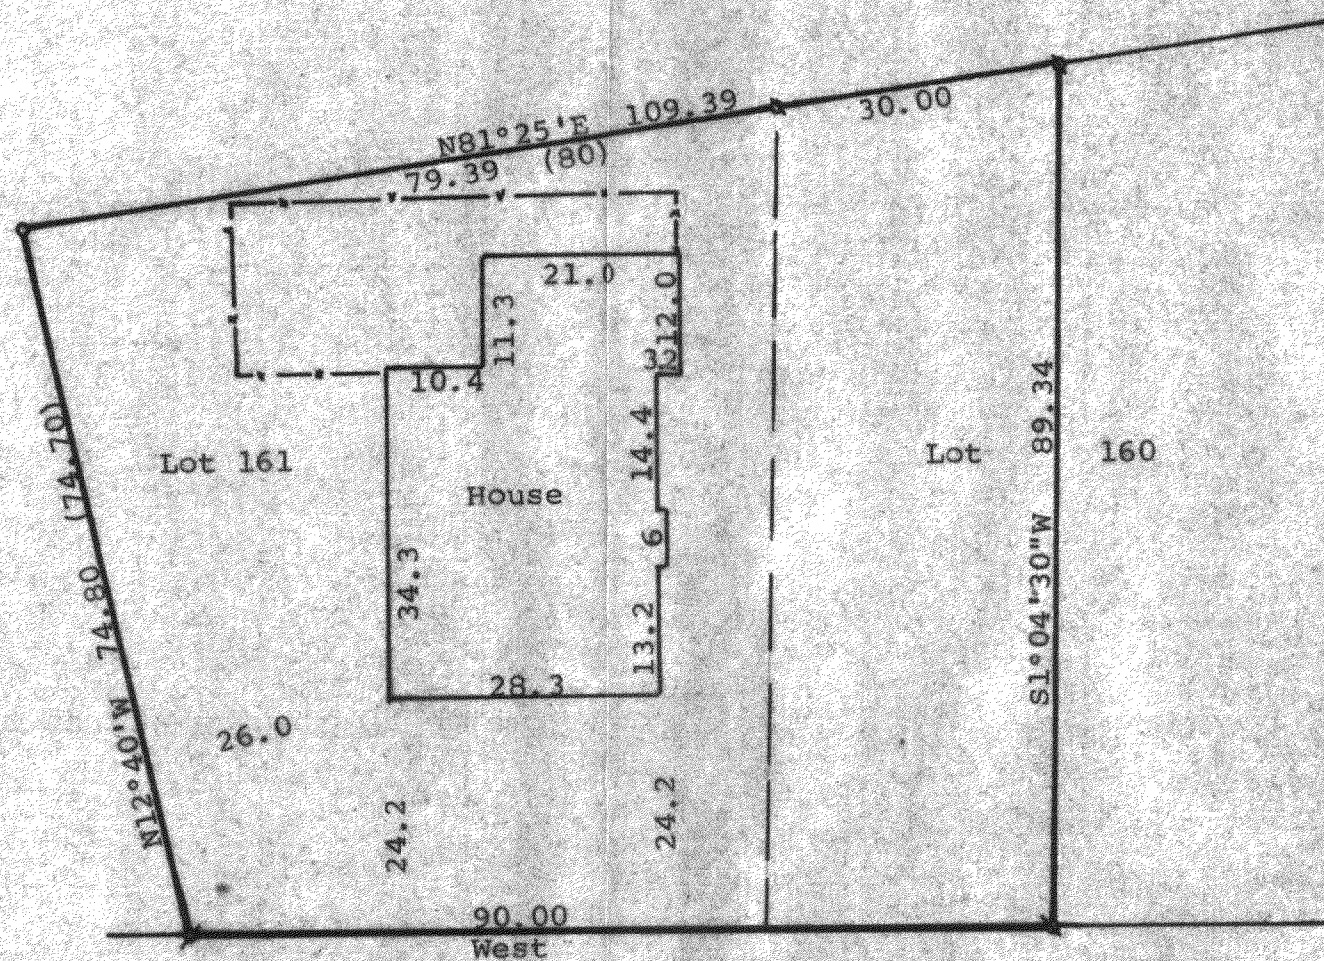

Scale - 1" = 20'

• = 1/2" Iron Pipe Found

• = 3/4" Iron Pipe Found

• = 1" Iron Pipe Found

(0.00) = recorded distance

Bearings used are referenced to the assumed bearing of West along Wilmette Road

Survey ordered by:

Fleet Mortgage

2433 N. Mayfair Road

Wauwatosa, WI 53226

--- Fence Line

STATE OF WISCONSIN)
COUNTY OF WALWORTH) SS

I, George T. Dunham, Surveyor, certify that I have surveyed the property described as follows:

Lot 161 and the West 30 feet of Lot 160 of the 2nd Addition to Cedar Point Park, located in the Village of Williams Bay, Walworth County, Wisconsin,

and that the plat shown above is a true representation thereof and shows the size and location of the property, its exterior boundaries, the location of all visible structures and dimensions of all principal buildings thereon, boundary fences, apparent easements, roadways and visible encroachments, if any, and that I have surveyed the property hereon described according to the official records to the best of my knowledge and belief.

November 15, 1984

George T. Dunham
George T. Dunham, Surveyor

