


RECEIVED
DEC 16 1985
JK L

KOLB LAND CONSULTING, INC.
LAND SURVEYING • SUBDIVIDING • LAND PLANNING

929 WILLIAMS STREET LAKE GENEVA, WISCONSIN 53147 414-248-3697

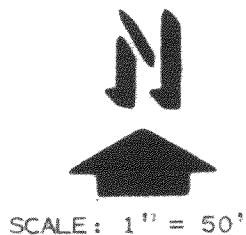

SCALE: 1" = 50'

IRON PIPE IN TREE
LEGEND

() - AS RECORDED


SW - SIDE WALK

Ø - IRON PIPE FOUND

Δ - UTILITY POLE

— OVER HEAD UTILITY
LINE

└ - UTILITY POLE ANCHOR

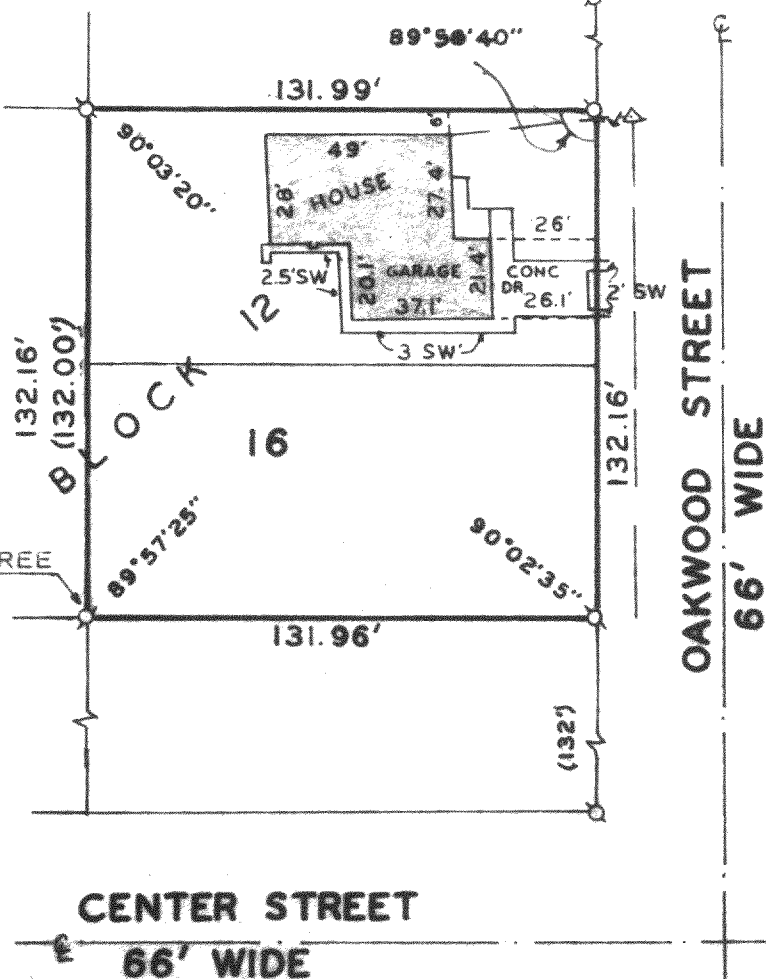

ORDERED BY: HOTTON REALTY
54 WEST GENEVA ST.
WILLIAMS BAY, WI. 53191

PLAT OF SURVEY OF

LOTS 13 & 16, BLOCK 12 OF WILLIAMS SECOND ADDITION,
VILLAGE OF WILLIAMS BAY, WALWORTH COUNTY, WISCONSIN.

I HEREBY CERTIFY THAT I HAVE SURVEYED THE ABOVE DESCRIBED PROPERTY AND THAT THE ABOVE MAP IS A TRUE REPRESENTATION THEREOF AND SHOWS THE SIZE AND LOCATION OF THE PROPERTY, ITS EXTERIOR BOUNDARIES, THE LOCATION OF ALL VISIBLE STRUCTURES AND DIMENSIONS OF ALL PRINCIPAL BUILDINGS THEREON, BOUNDARY FENCES, APPARENT EASEMENTS, ROADWAYS AND VISIBLE ENCROACHMENTS, IF ANY, TO THE BEST OF MY KNOWLEDGE AND BELIEF.

THIS SURVEY IS MADE FOR THE USE OF THE PRESENT OWNERS OF THE PROPERTY, AND ALSO THOSE WHO PURCHASE, MORTGAGE, OR GUARANTEE THE TITLE THERETO WITHIN ONE (1) YEAR FROM DATE HEREOF.

Harold H. Kolb
HAROLD H. KOLB

WISCONSIN REGISTERED LAND SURVEYOR, S-187

DATE OCTOBER 11, 1985

REVISED

REVISED

