


FARRIS, HANSEN & ASSOCIATES, INC.
7 RIDGEWAY COURT ELKHORN, WI
414-723-2098

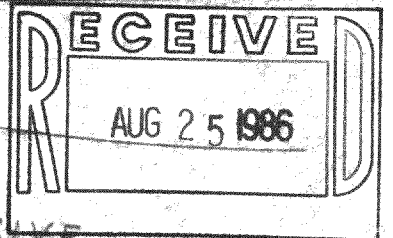

Plat of Survey of lot 56 of Willabay Woods
Located in the Northeast 1/4 of the Northeast
1/4 of Section 6, Town 1 North, Range 17 East
Village of Williams Bay, Walworth County Wisconsin

WORK ORDERED BY: Midwest Realty

N

W.L.N. LOT 56
N 1° 17' W AS RECORDED

LOT 58

LOT 56

LOT 55

LOT 57

DRAINAGE & UTILITY EASEMENT 15'

238.04

130.95'
(131.04)

N 1° 17' W

107.10'
(107.00)

N 88° 51' 30" W

101.00'

CONC. SLAB
POWER & TELE. TV
JUNCTION BOXES

P.Pole

OH WIRES

DRAINAGE & UTILITY EASEMENT 105'

DECORATIVE WOOD FENCE 1' ALONG LN

225.54'


N 1° 21' W

EVANGELICAL FREE CHURCH SUBD.

10 0 10 50 100
Map Scale in Feet

LEGEND

- Ø = Iron Pipe Survey Stake Found
- = Iron Pipe Survey Stake Set
- (XXX) = Record Dimension

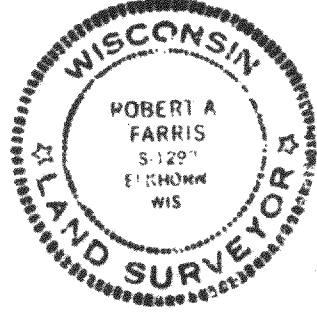

CERTIFICATE

I hereby certify that the above described property has been surveyed under my direction and that the above map is a true representation thereof and shows the size and location of the property, its exterior boundaries, the location of all visible structures and dimensions of all principal buildings thereon, boundary fences, apparent easements, roadways and visible encroachments, if any.
This survey is made for the use of the present owners of the property, and also for those who purchase, mortgage, or guarantee the title thereto within one (1) year from the date hereof.

Robert A. Farris
Robert A. Farris, R.L.S.

Dated this 18 day of JULY, 1986

PROJECT NO. 2624