




PLAT OF SURVEY

OF

LOT 125 AND PART OF LOT 124, CEDAR POINT
PARK 2ND ADDITION, LOCATED IN THE NE $\frac{1}{4}$
OF SECTION 6, T1N R1E, VILLAGE OF
WILLIAMS BAY, WALKWORTH COUNTY, WISCONSIN.

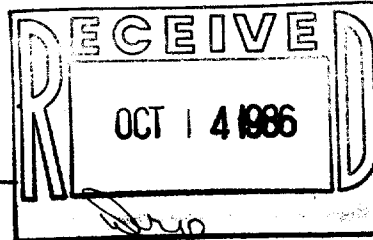

HIGHLAND ROAD

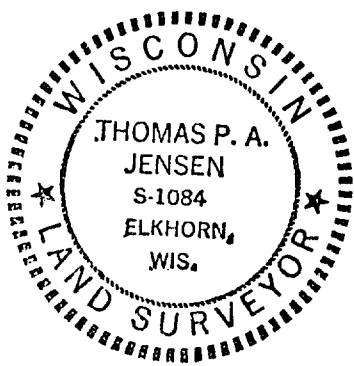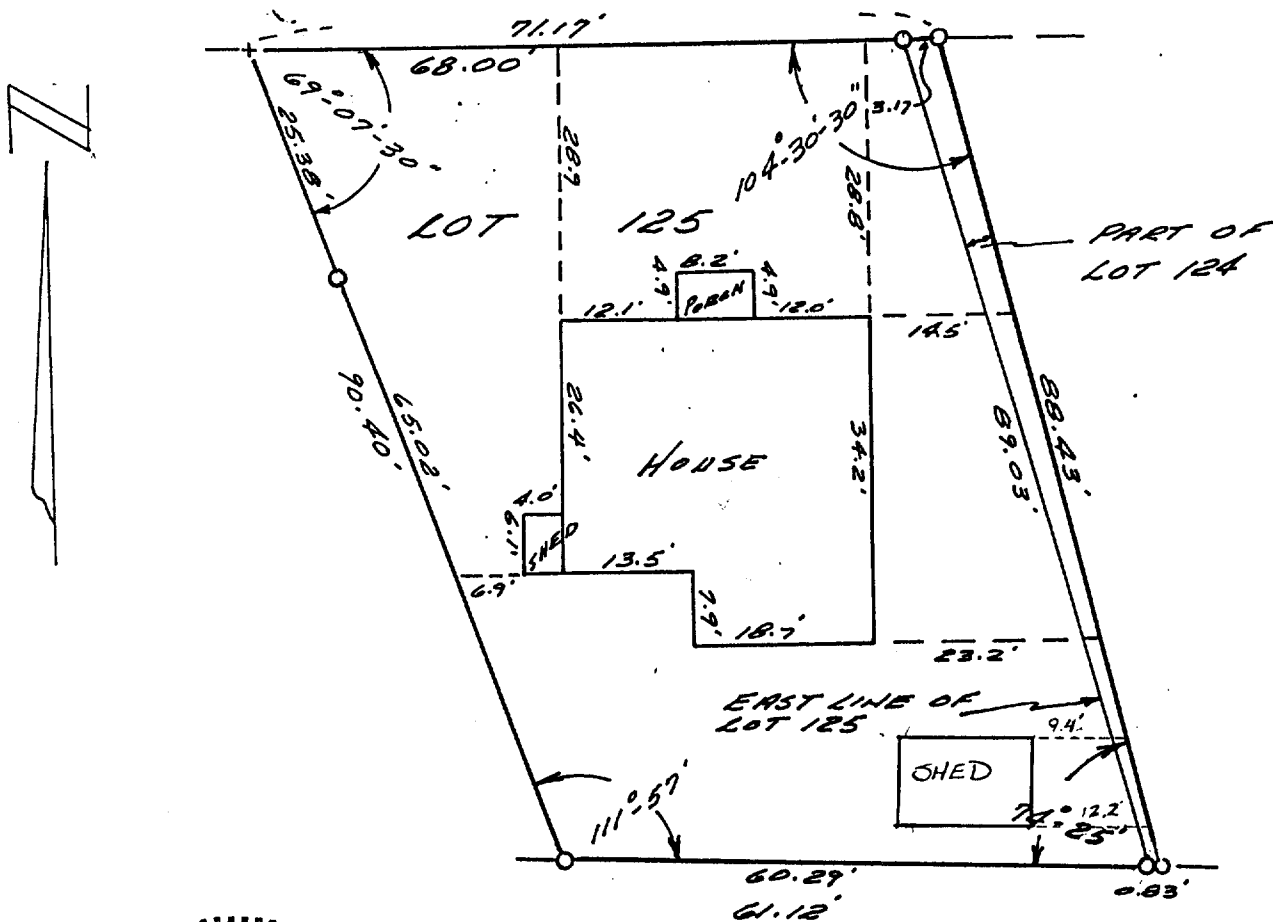

Recertified by: Jensen Surveying & Mapping S.C.
45 S. Wis. P.O. Box 322
Elkhorn, Wisconsin. 53121
June 25, 1986.

Thomas P. A. Jensen
Thomas P.A. Jensen S-1084

SURVEY AND PLAT BY

JENSEN & JOHNSON, INC.
CIVIL ENGINEERS AND SURVEYORS

Elkhorn, Wisconsin

LEGEND

- Ø — Iron Pipe SET
- — Concrete Monument
- Scale 1" = 20

- — IRON PIPE FOUND
- + — CHISEL CROSS CUT FOUND

WE CERTIFY: That we have surveyed the above described property and that the plat shown hereon is an accurate survey and a true representation thereof and correctly shows the exterior boundary lines and all divisions of said property, AND ALL BUILDINGS THEREON.

Date JULY 23, 1973

Thomas P. A. Jensen

Wisconsin Registered Land Surveyor, No. S-1084