


FARRIS, HANSEN & ASSOCIATES, INC.
7 RIDGEWAY COURT, ELKHORN, WI
414-723-2098

PLAT OF SURVEY OF
LOT 10 WILLABAY WOODS


Located in the Northeast 1/4 of the Northeast
1/4 of Section 6, Town 1 North, Range 17 East
Village of Williams Bay, Walworth County Wisconsin

WORK ORDERED BY: Midwest Realty

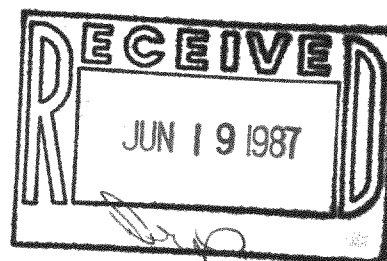

.....LEGEND.....

- = IRON ROD STAKE SET
- ⊙ = IRON PIPE STAKE FOUND
- = IRON ROD STAKE FOUND
- (XXXX) = RECORD DIMENSION

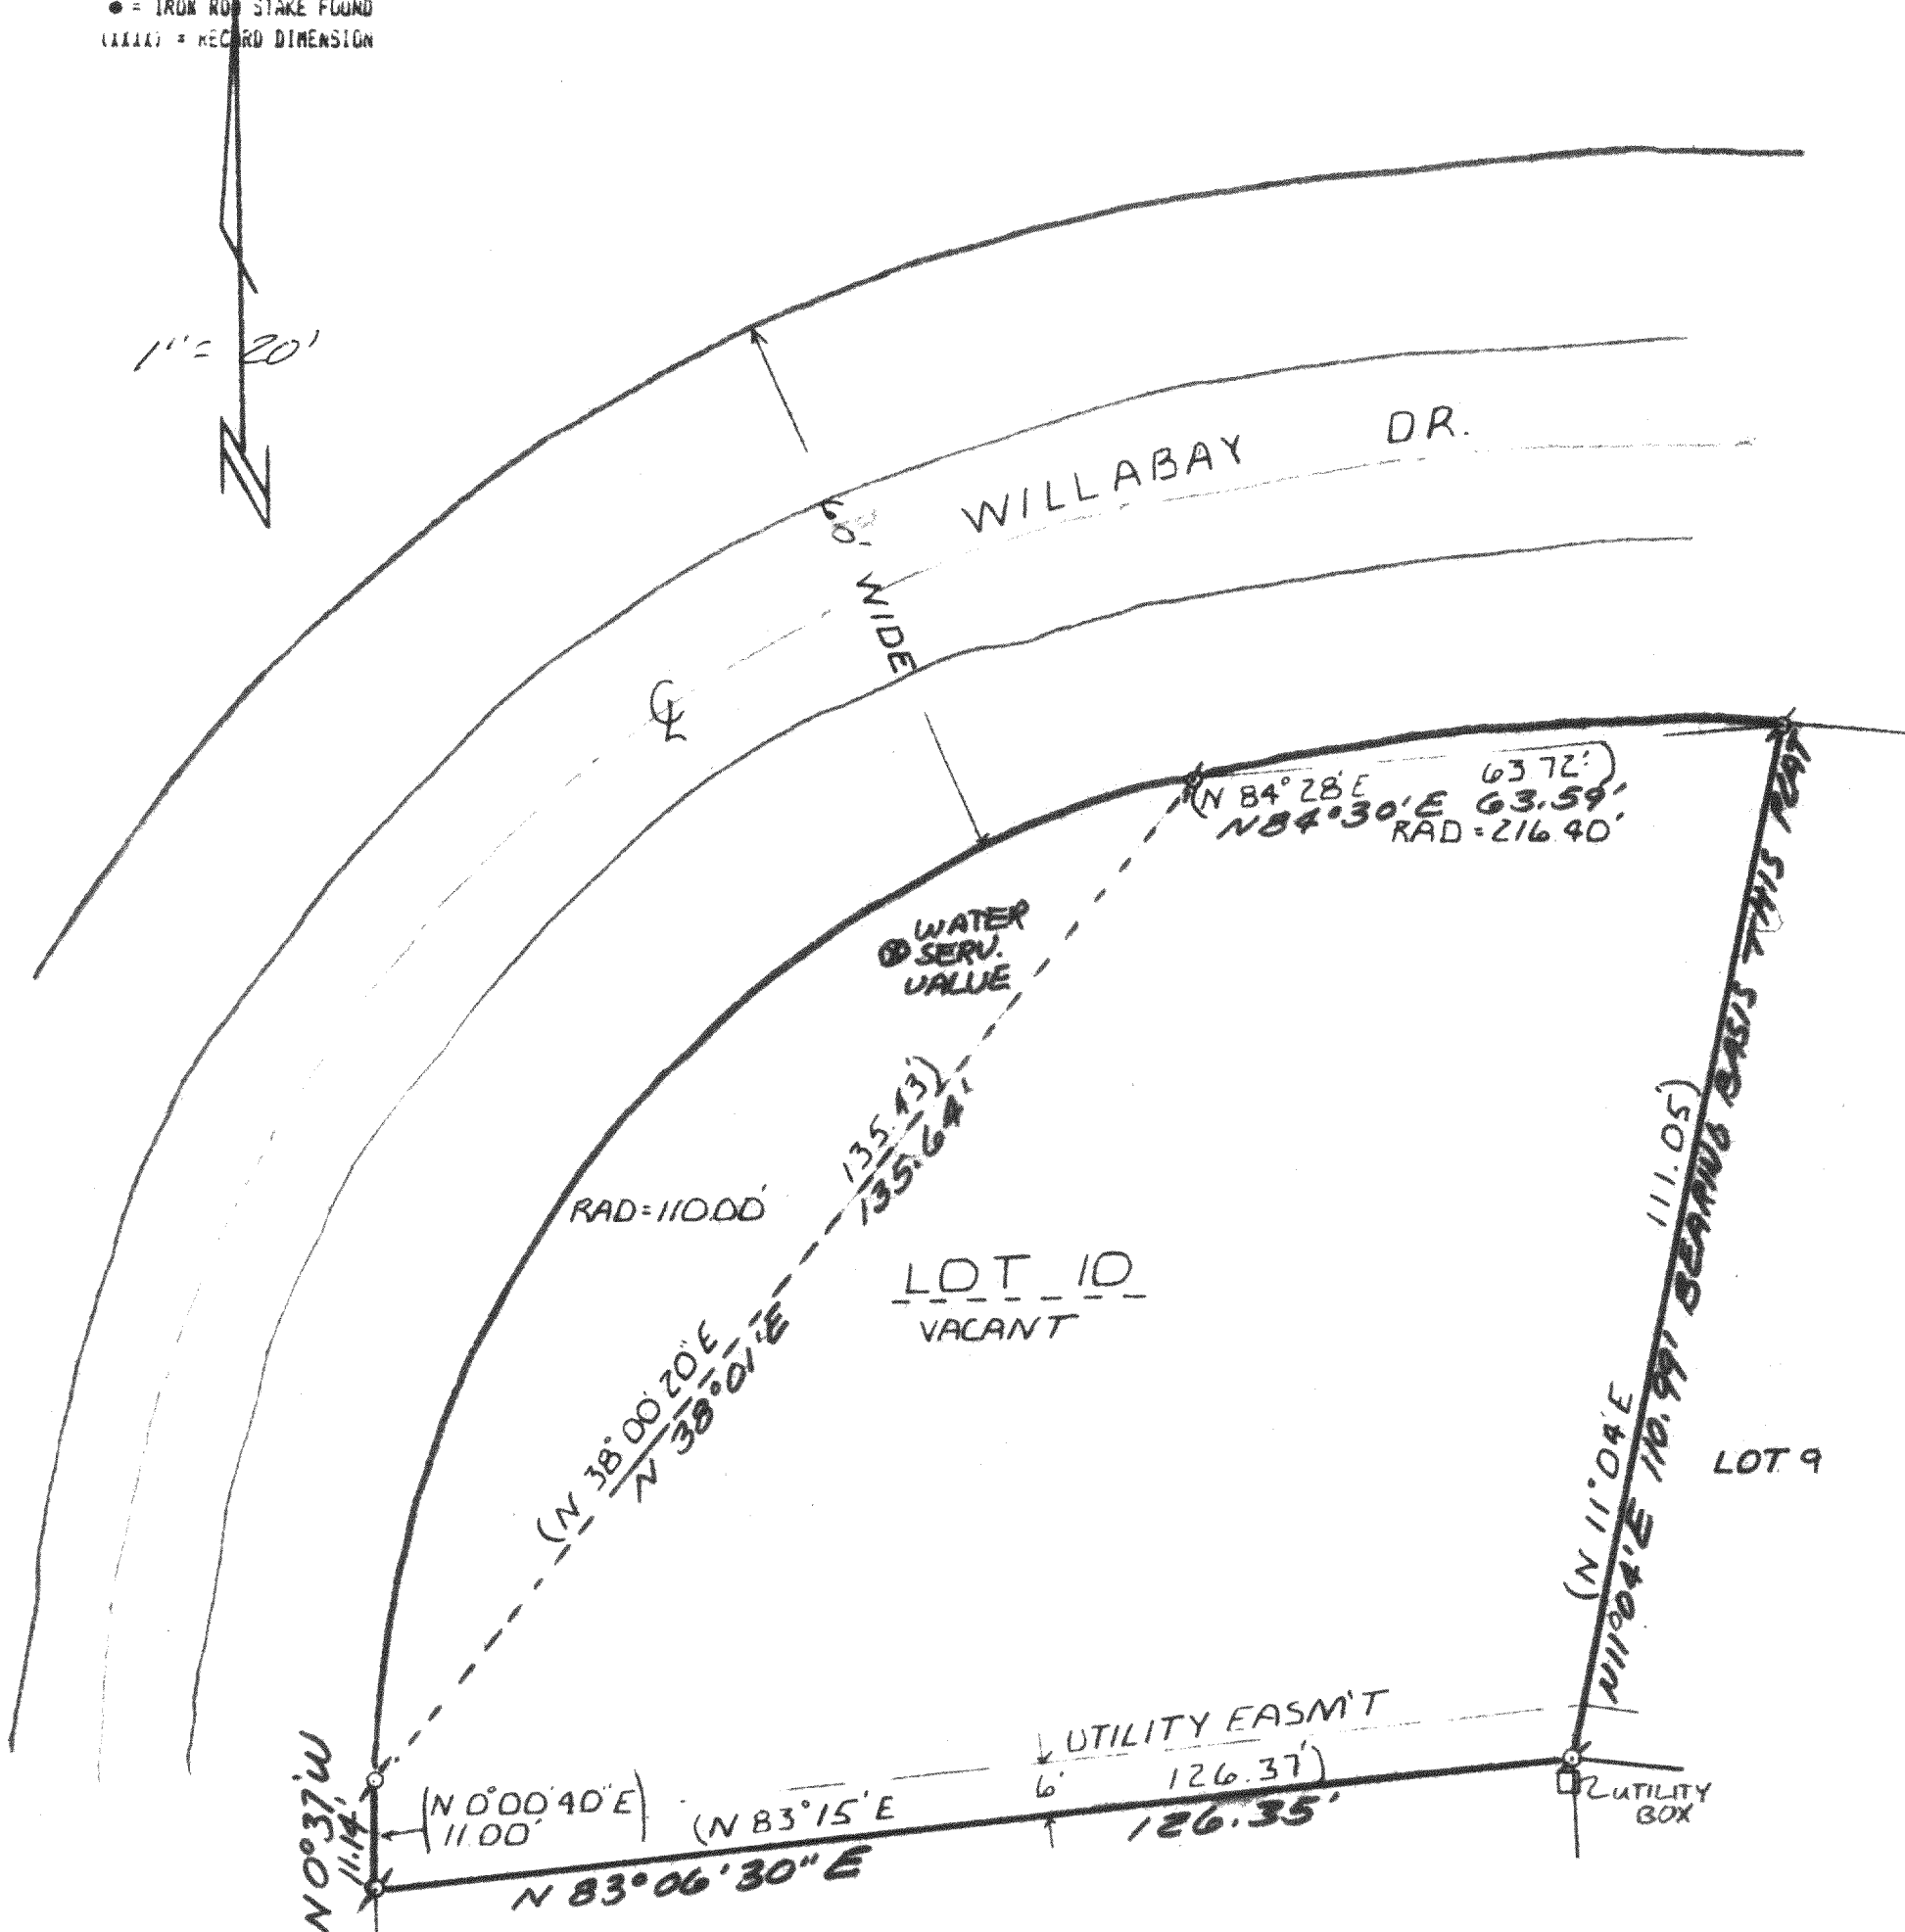

I hereby certify that I have surveyed the above described property and that the above map is a true representation thereof and shows the size and location of the property, its exterior boundaries, the location of all visible structures and dimensions of all principal buildings thereon, boundary fences, apparent easements, roadways and visible encroachments, if any.

This survey is made for the use of the present owners of the property, and also those who purchase, mortgage, or guarantee the title thereto within one (1) year from the date hereof.

Dated this 8th day of June 1987
PROJECT NO. 2819

Robert A. Farris

