





TEL. 414-723-2098


MAP LEGEND

 = IRON PIPE STAKE FOUND



 = IRON PIPE STAKE SET

 = IRON ROD STAKE FOUND

 = IRON ROD STAKE SET


 = CONCRETE MONUMENT FOUND

XX ) = RECORD DIMENSION

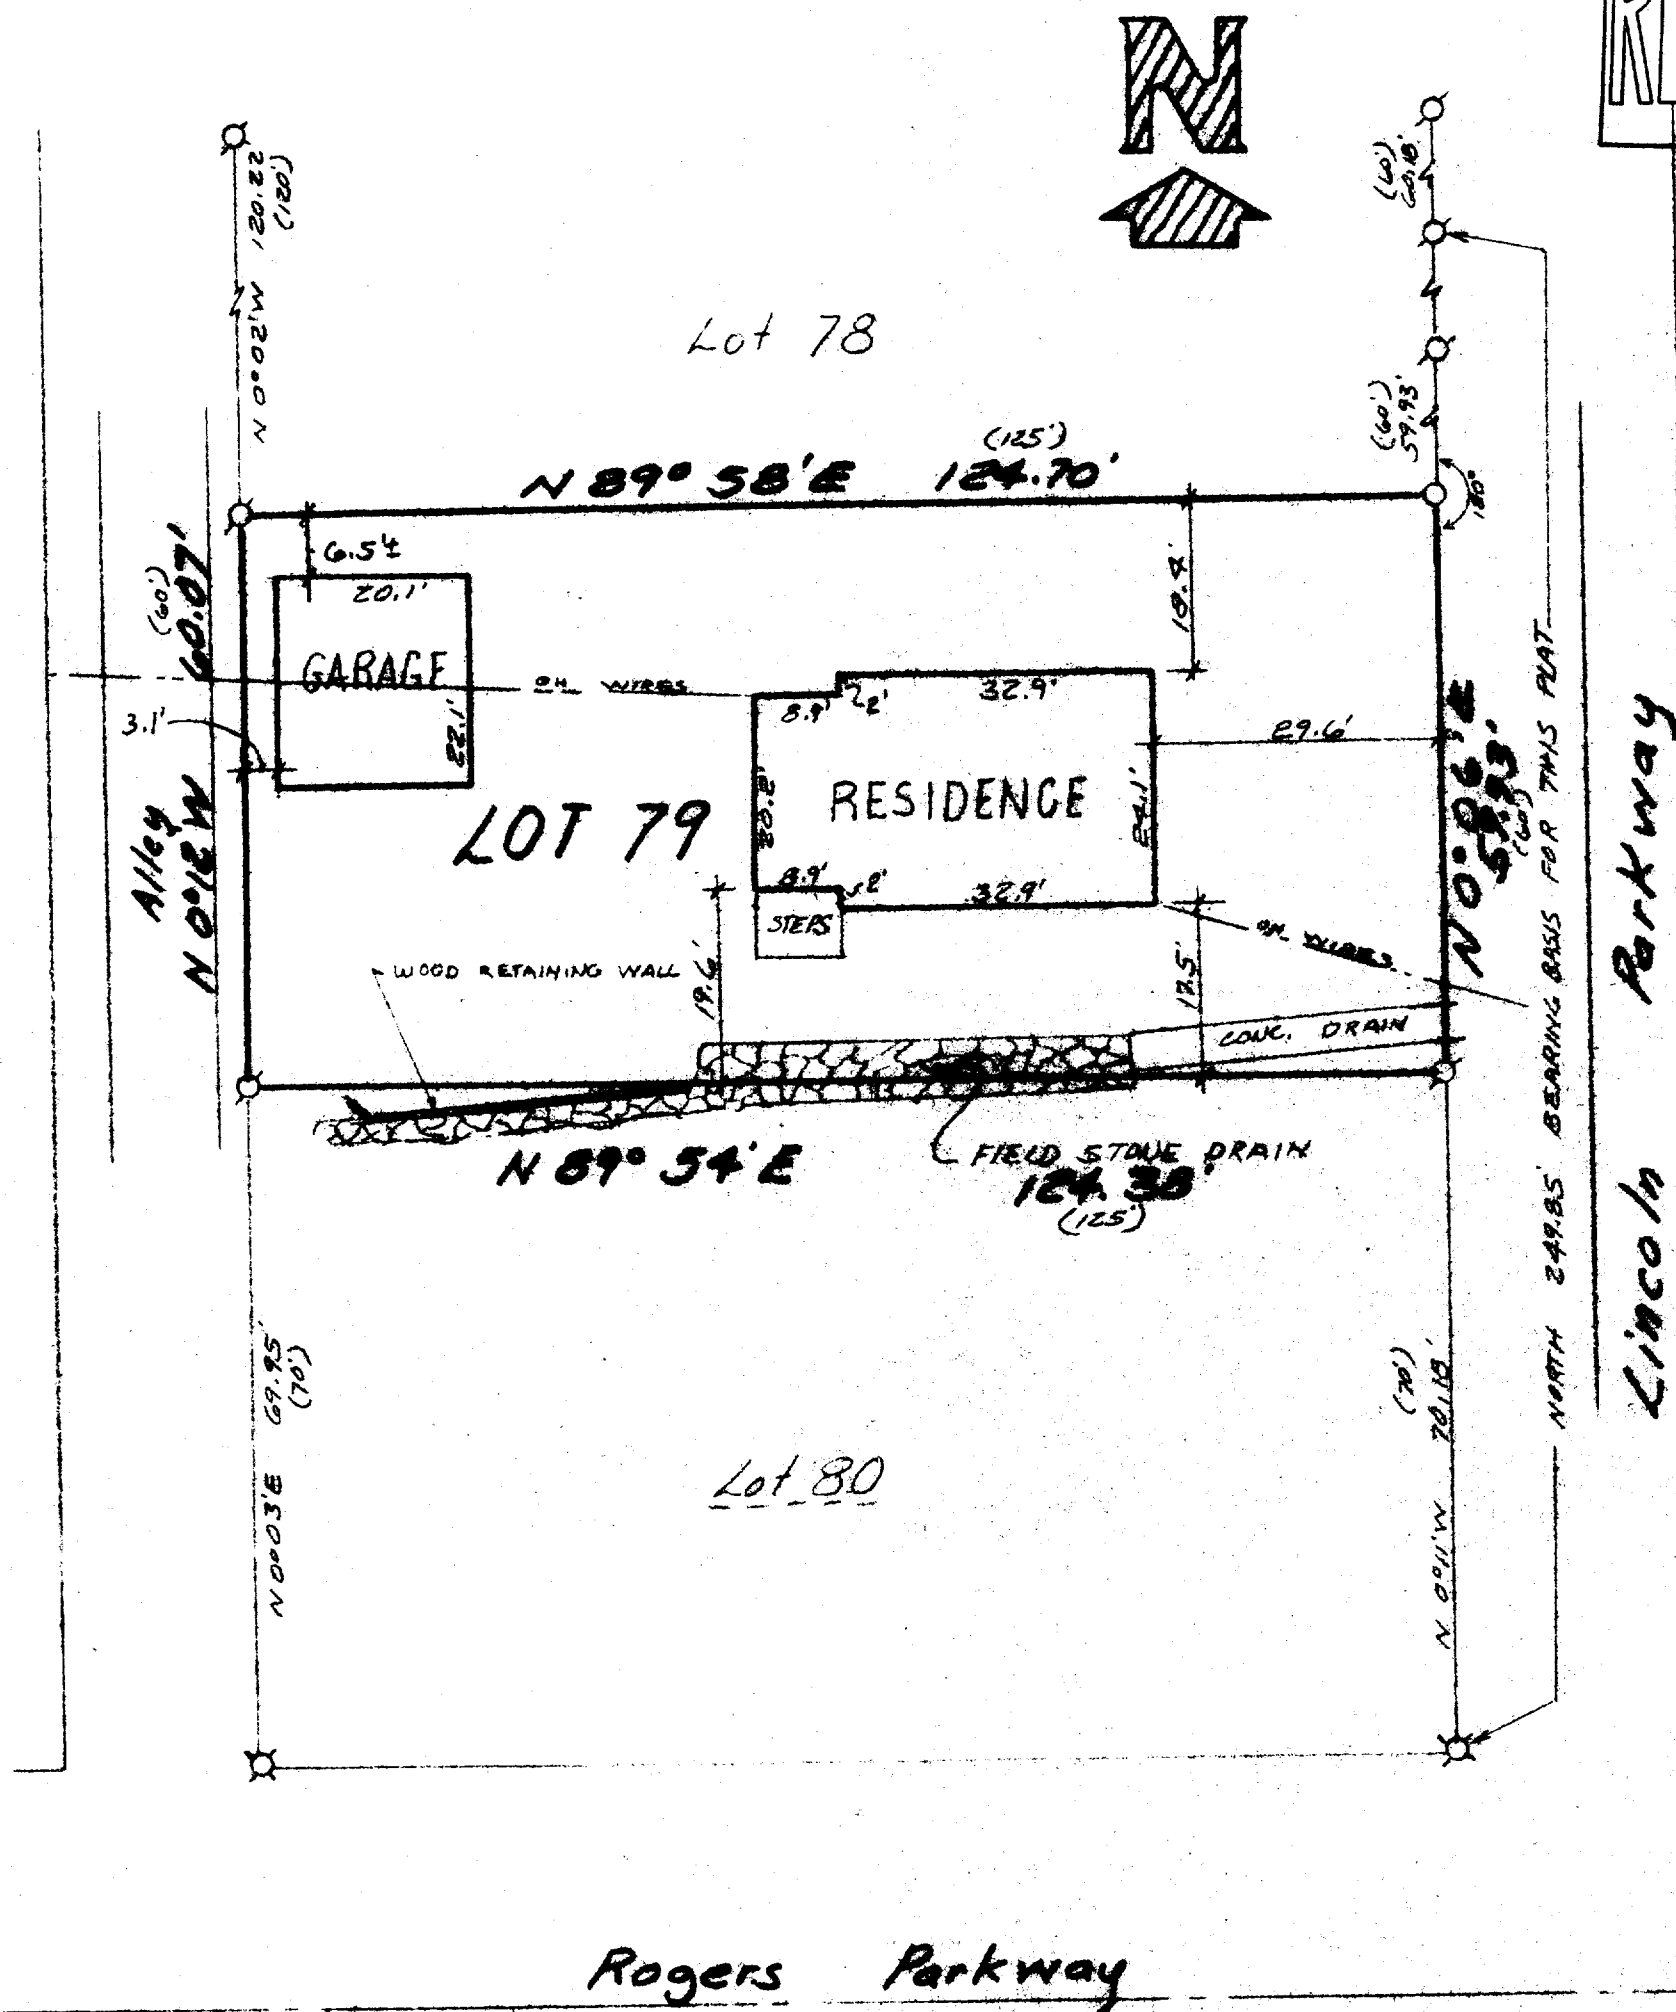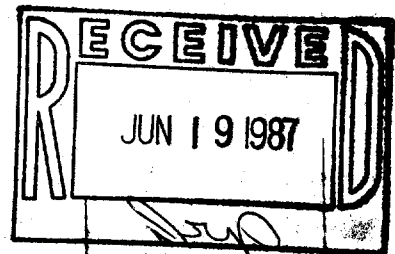

DATED : JUNE 8, 1987

Robert C. Farnsworth

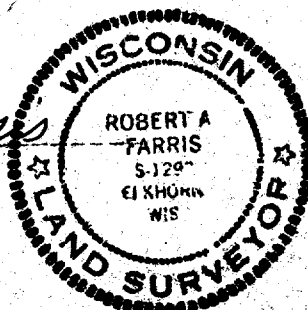

PROJ. NO. 2807