


GEORGE T. DUNHAM
SURVEYING & SUBDIVIDING
DELAVER, WISCONSIN

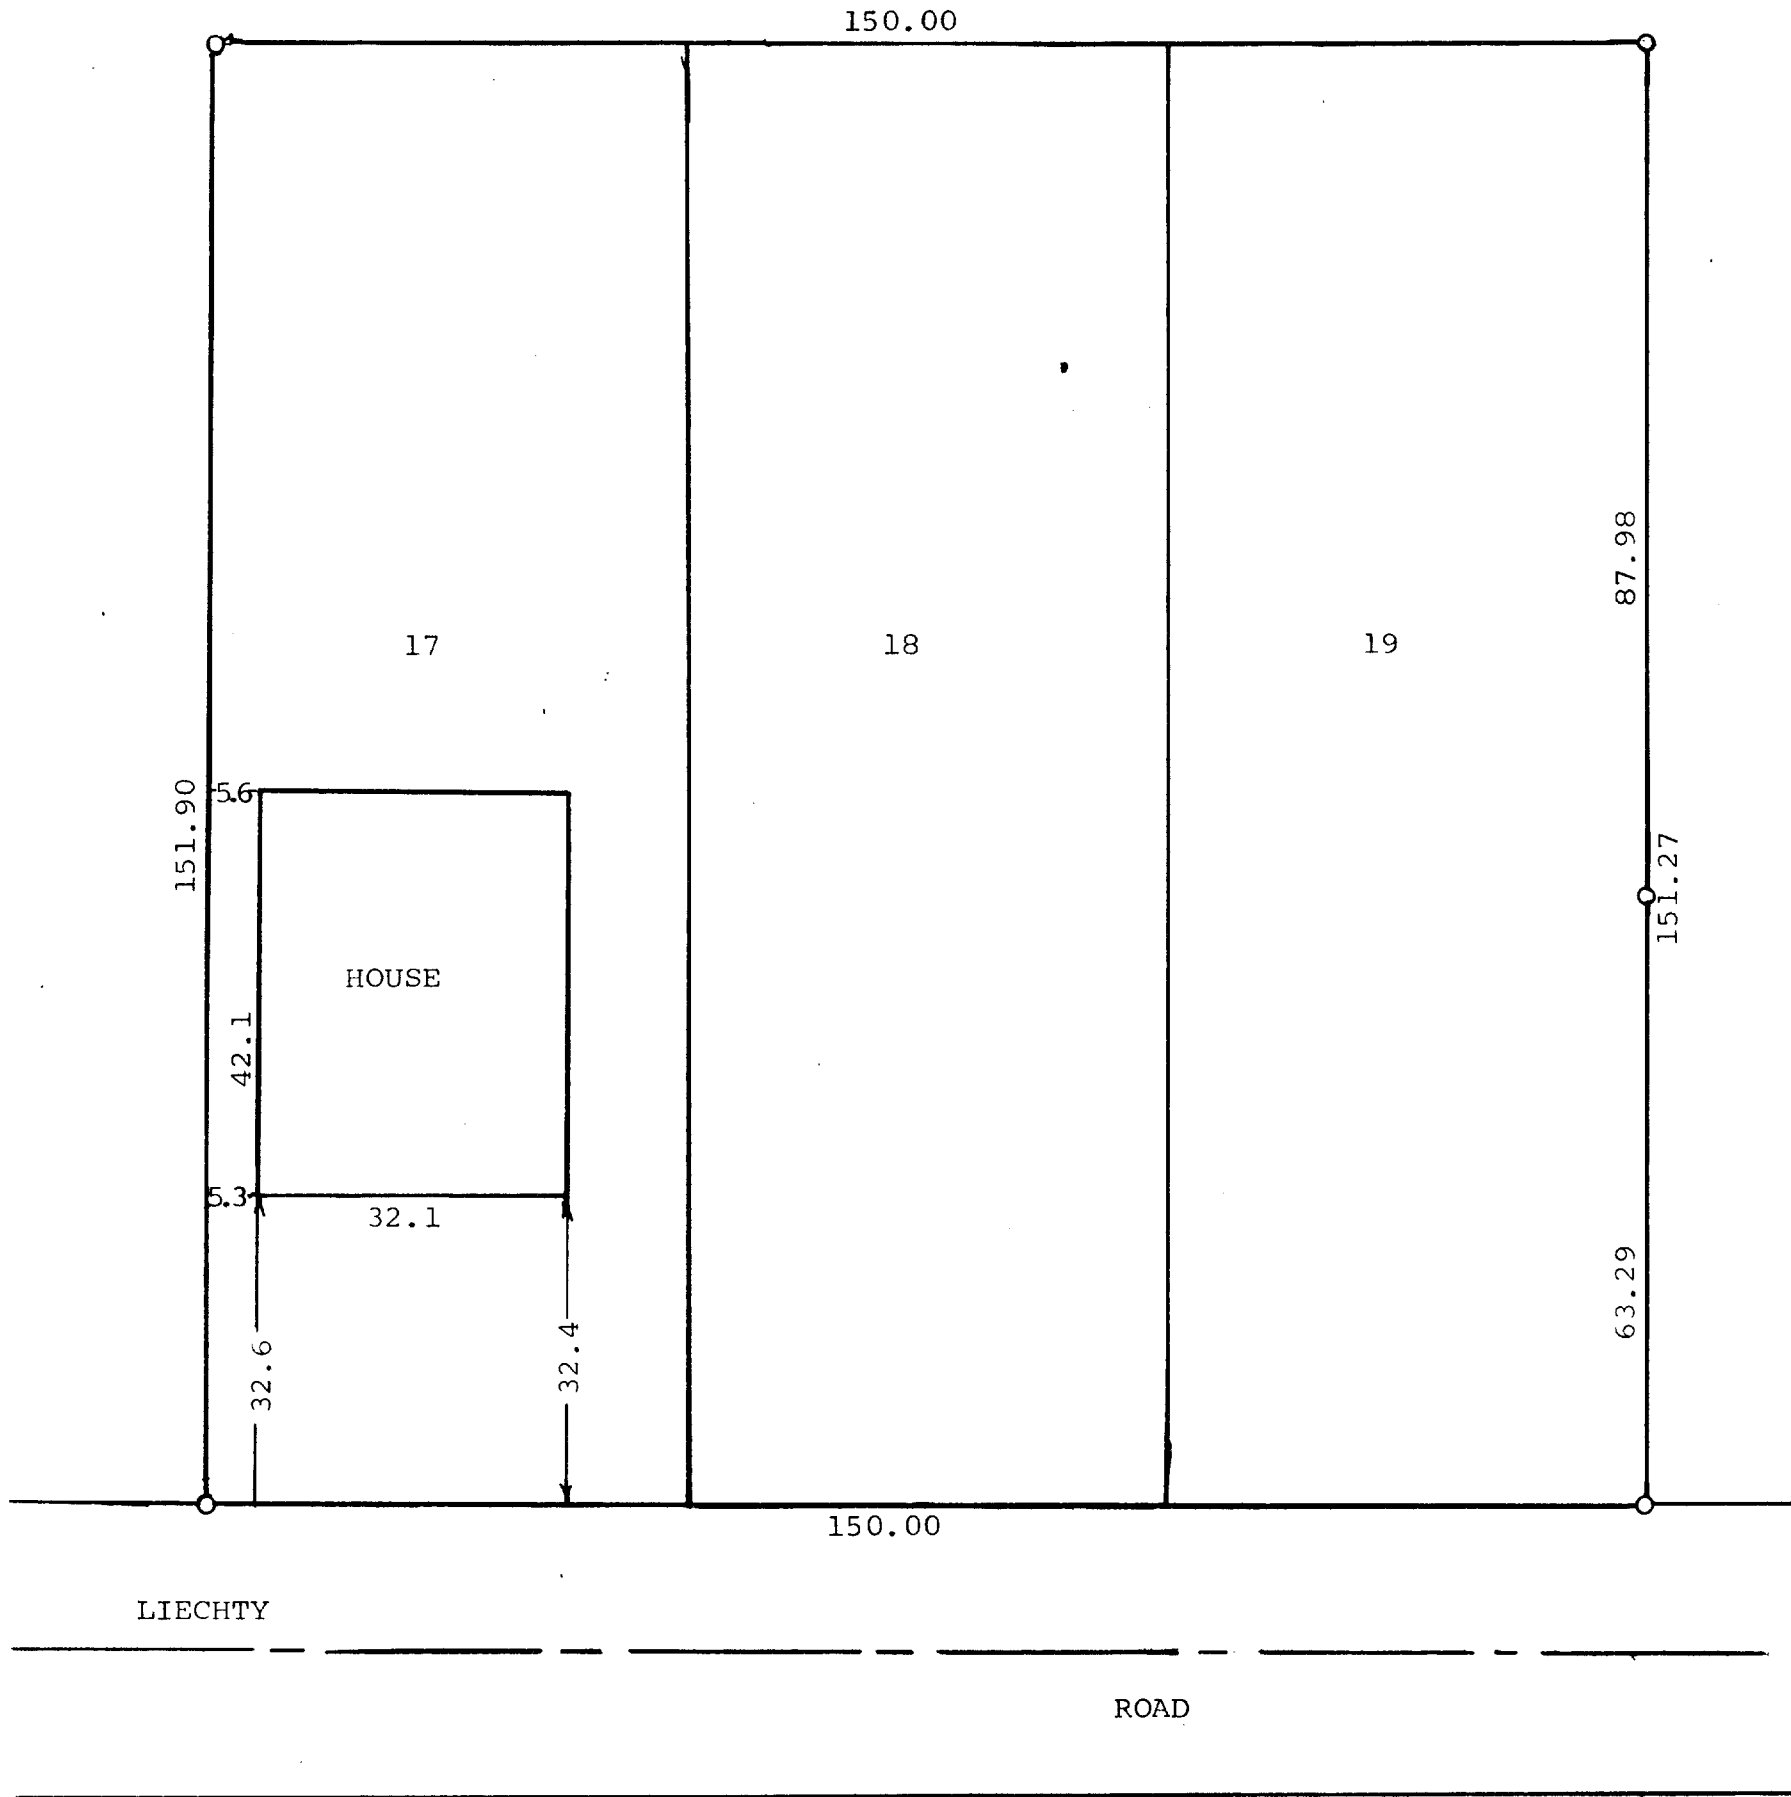

Scale - 1" = 20'
O = Iron pipe

Plat of survey of Lots 17, 18, & 19 of Summer Haven,
a subdivision located in the Village of Williams Bay,
Walworth County, Wisconsin.
July 31, 1970

George T. Dunham
George T. Dunham, Surveyor

11-65