


GENEVA STREET

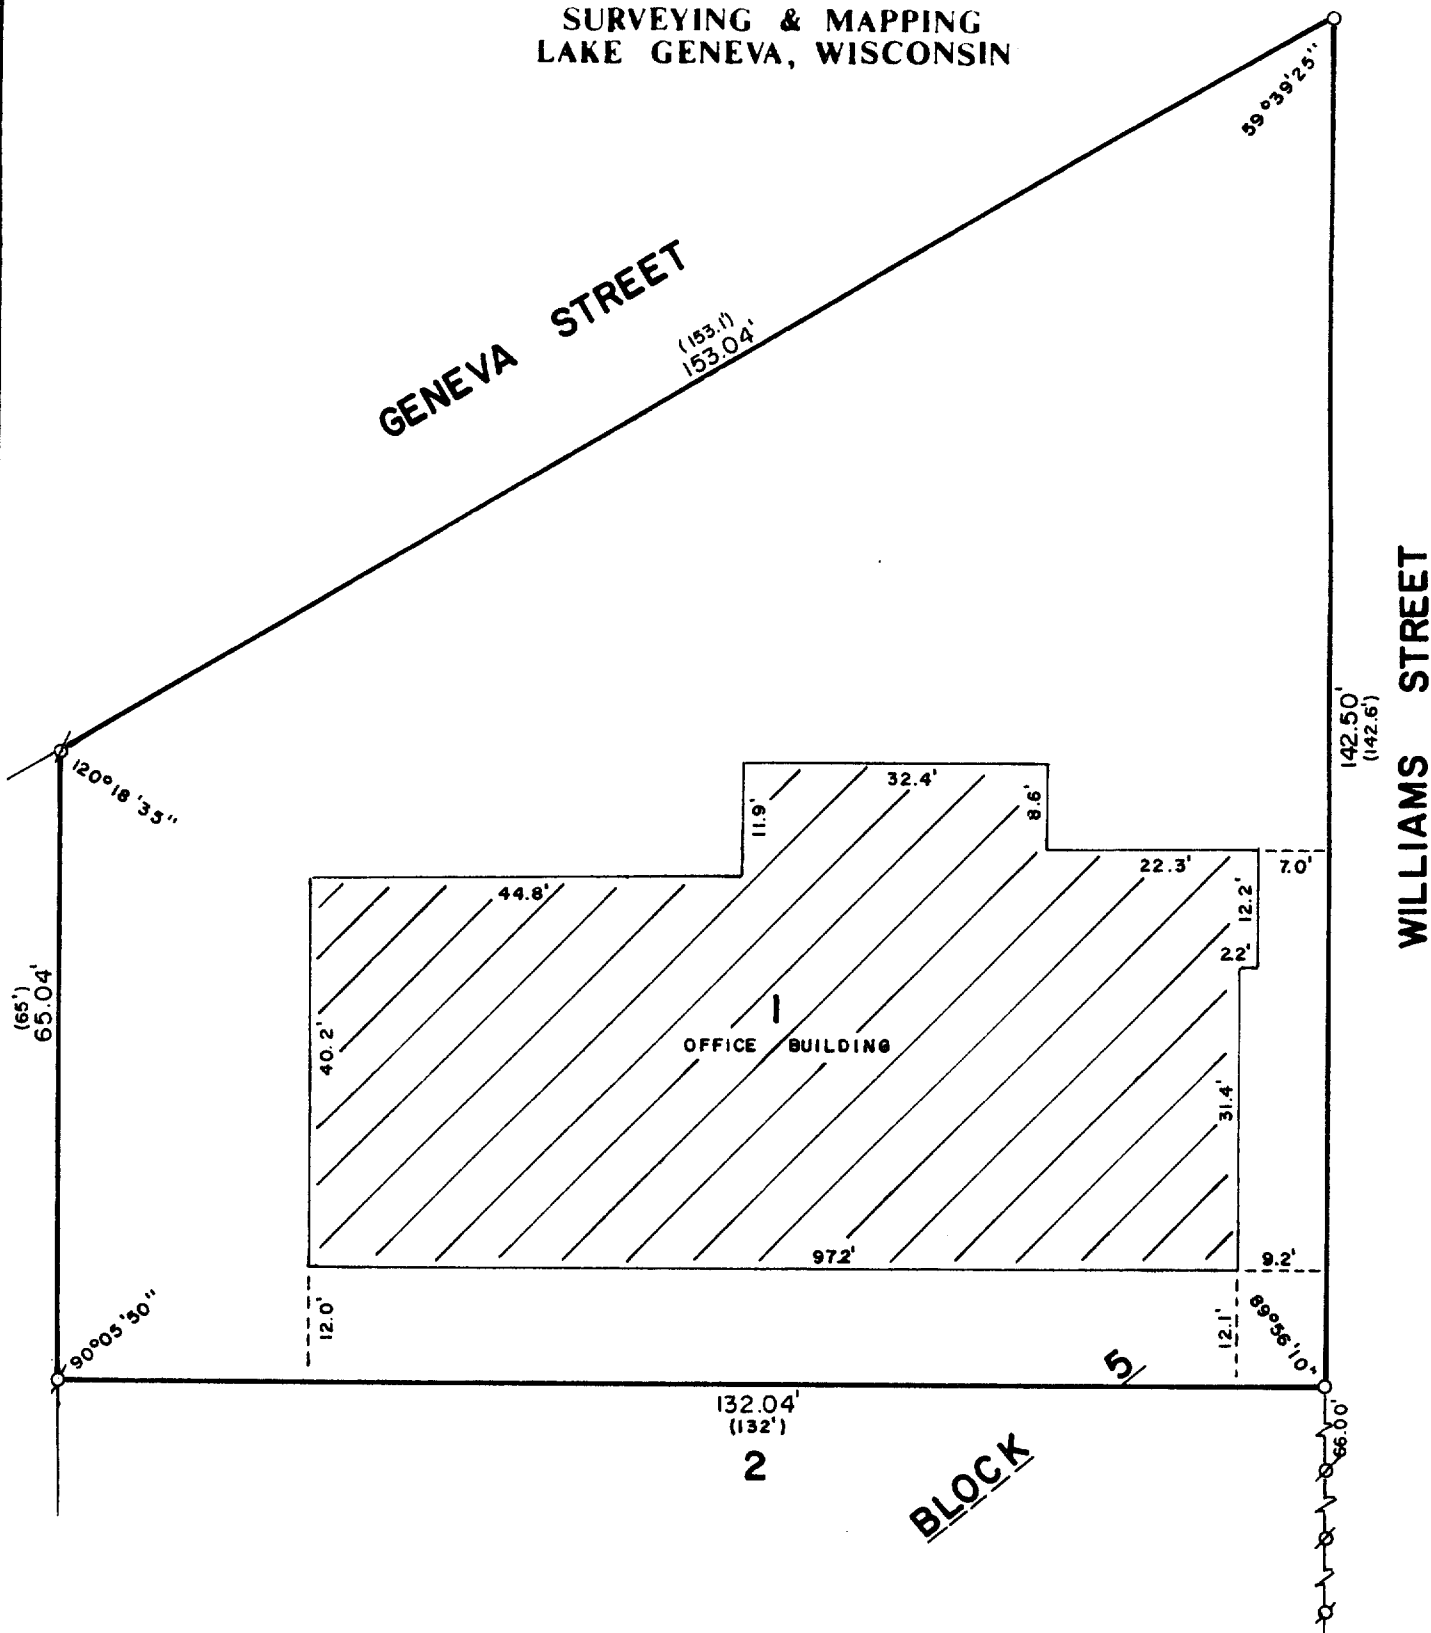

LOT 1, BLOCK 5 OF THE ORIGINAL PLAT  
OF THE VILLAGE OF WILLIAMS BAY,  
WALWORTH COUNTY, WISCONSIN.



ORDERED BY: KEEFE REAL ESTATE  
704 MAIN STREET  
LAKE GENEVA, WISCONSIN  
53147

I, ROBERT M. BAERENWALD, DO HEREBY CERTIFY THAT I HAVE SURVEYED THE PROPERTY HEREON DESCRIBED ACCORDING TO THE OFFICIAL RECORDS AND THAT THE PLAT HEREON IS A CORRECT REPRESENTATION OF THE PROPERTY LINES TO THE BEST OF MY KNOWLEDGE AND BELIEF.

Robert M. Baehenwald  
ROBERT M. BAEHENWALD  
WISCONSIN REGISTERED LAND SURVEYOR, S-1508

DATE April 30, 1958 JOB NO. 1497

NOTE: THIS IS NOT A CERTIFIED COPY UNLESS SEALED. 11-650

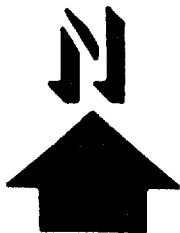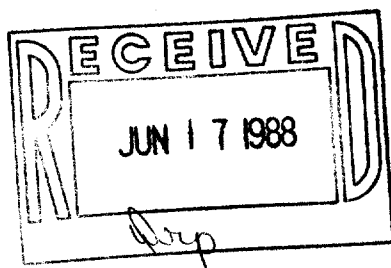

SCALE: 1"=20'

♂ - IRON PIPE FOUND  
 ∅ - IRON ROD FOUND  
 ○ - IRON ROD PLACED  
 ( ) - RECORDED AS

WOF-62