
## WALWORTH COUNTY SURVEYING & MAPPING LAKE GENEVA, WISCONSIN



## PLAT OF SURVEY OF

LOT 8, BLOCK 9 OF WILLIAM'S SECOND ADD. TO THE VILLAGE OF WILLIAMS BAY, WALWORTH COUNTY, WISCONSIN.

ORDERED BY: RICHARD RASMUSSEN WALWORTH, WISCONSIN

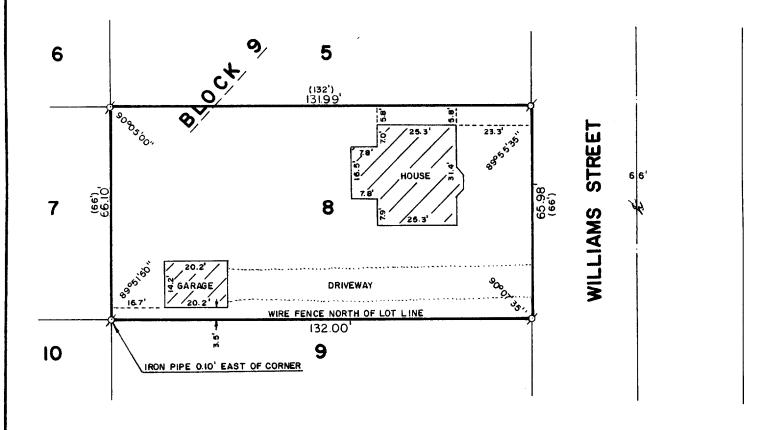

SCALE: 1"=30'

ø-IRON PIPE FOUND
()-RECORDED AS

THEREBY CENTIFY THAT THAVE SURVEYED THE ABOVE DESCRIBED PROPERTY AND THAT THE ABOVE MAP IS A TRUE REPRESENTATION THEREOF AND BHOWS THE SIZE AND LOCATION OF THE PROPERTY. ITS EXTERIOR BOUNDARIES, THE LOCATION OF ALL VISIBLE STHUCTURES AND DIMENSIONS OF ALL PRINCIPAL BUILDINGS THEREON, BOUNDARY FENCES, APPARENT EASEMENTS AND ROADWAYS AND VISIBLE ENCROACHMENTS, IF ANY.

THIS SURVEY IS MADE FOR THE EXCLUSIVE USE OF THE PRESENT OWNERS OF THE PROPERTY, AND ALSO THOSE WHO PURCHASE, MORTGAGE, OR GUARANTEE THE TITLE THERETO WITHIN ONE (I) YEAR FROM DATE HEREOF.

ROBERT M. BAERENWALD
WISCONSIN REGISTERED LAND SURVEYOR, S-1508

DATE JOB NO. 1699

NOTE: THIS IS NOT A CERTIFIED COPY UNLESS SEALED.

1000 E-150