



WALWORTH COUNTY
SURVEYING & MAPPING
LAKE GENEVA, WISCONSIN

LINCOLN PARKWAY

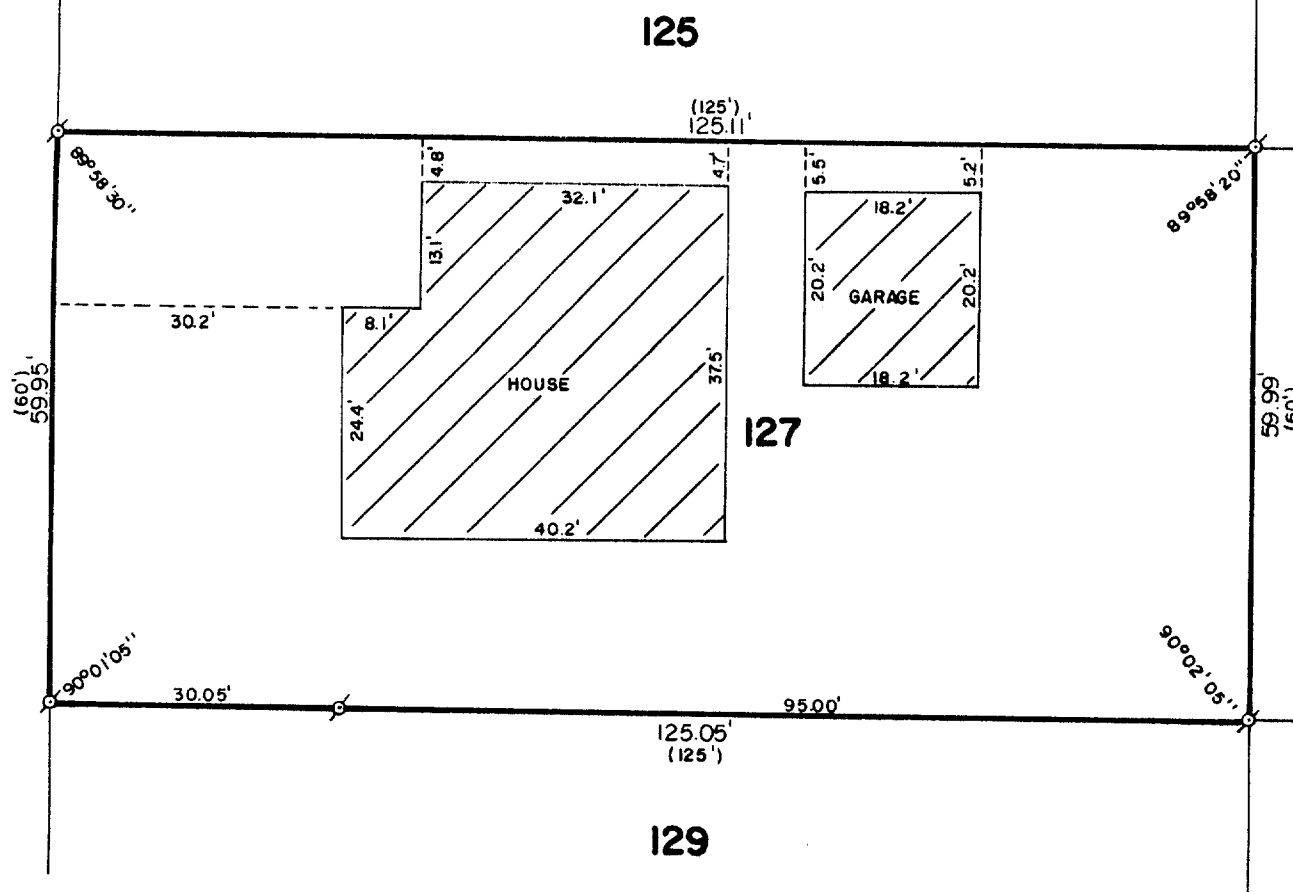


PLAT OF SURVEY OF

LOT 127 OF THE ORIGINAL PLAT OF CEDAR
POINT PARK, LOCATED IN THE VILLAGE OF
WILLIAMS BAY, WALWORTH COUNTY, WISCONSIN.

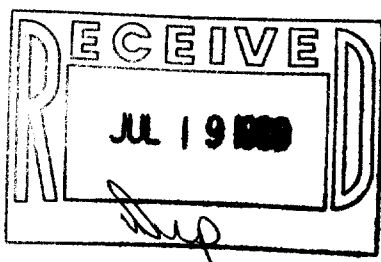

ORDERED BY: ASSURED REALTY
50 WEST GENEVA STREET
LAKE GENEVA, WISCONSIN
53127

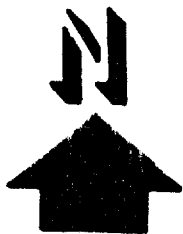

SCALE: 1"=20'

⊕ - IRON PIPE FOUND
() - RECORDED AS

I HEREBY CERTIFY THAT I HAVE SURVEYED THE ABOVE DESCRIBED PROPERTY AND THAT THE ABOVE MAP IS A TRUE REPRESENTATION THEREOF AND SHOWS THE SIZE AND LOCATION OF THE PROPERTY, ITS EXTERIOR BOUNDARIES, THE LOCATION OF ALL VISIBLE STRUCTURES AND DIMENSIONS OF ALL PRINCIPAL BUILDINGS THEREON, BOUNDARY FENCE, APPARENT EASEMENTS AND ROADWAYS AND VISIBLE ENCROACHMENTS, IF ANY.

THIS SURVEY IS MADE FOR THE EXCLUSIVE USE OF THE PRESENT OWNERS OF THE PROPERTY, AND ALSO THOSE WHO PURCHASE, MORTGAGE, OR GUARANTEE THE TITLE THERETO WITHIN ONE (1) YEAR FROM DATE HEREOF.

Robert M. Baerenwald
ROBERT M. BAERENWALD
WISCONSIN REGISTERED LAND SURVEYOR, S-1508

Feb. 22, 1989
DATE JOB NO. 1841

NOTE: THIS IS NOT A CERTIFIED COPY UNLESS SEALED.