


#51/72

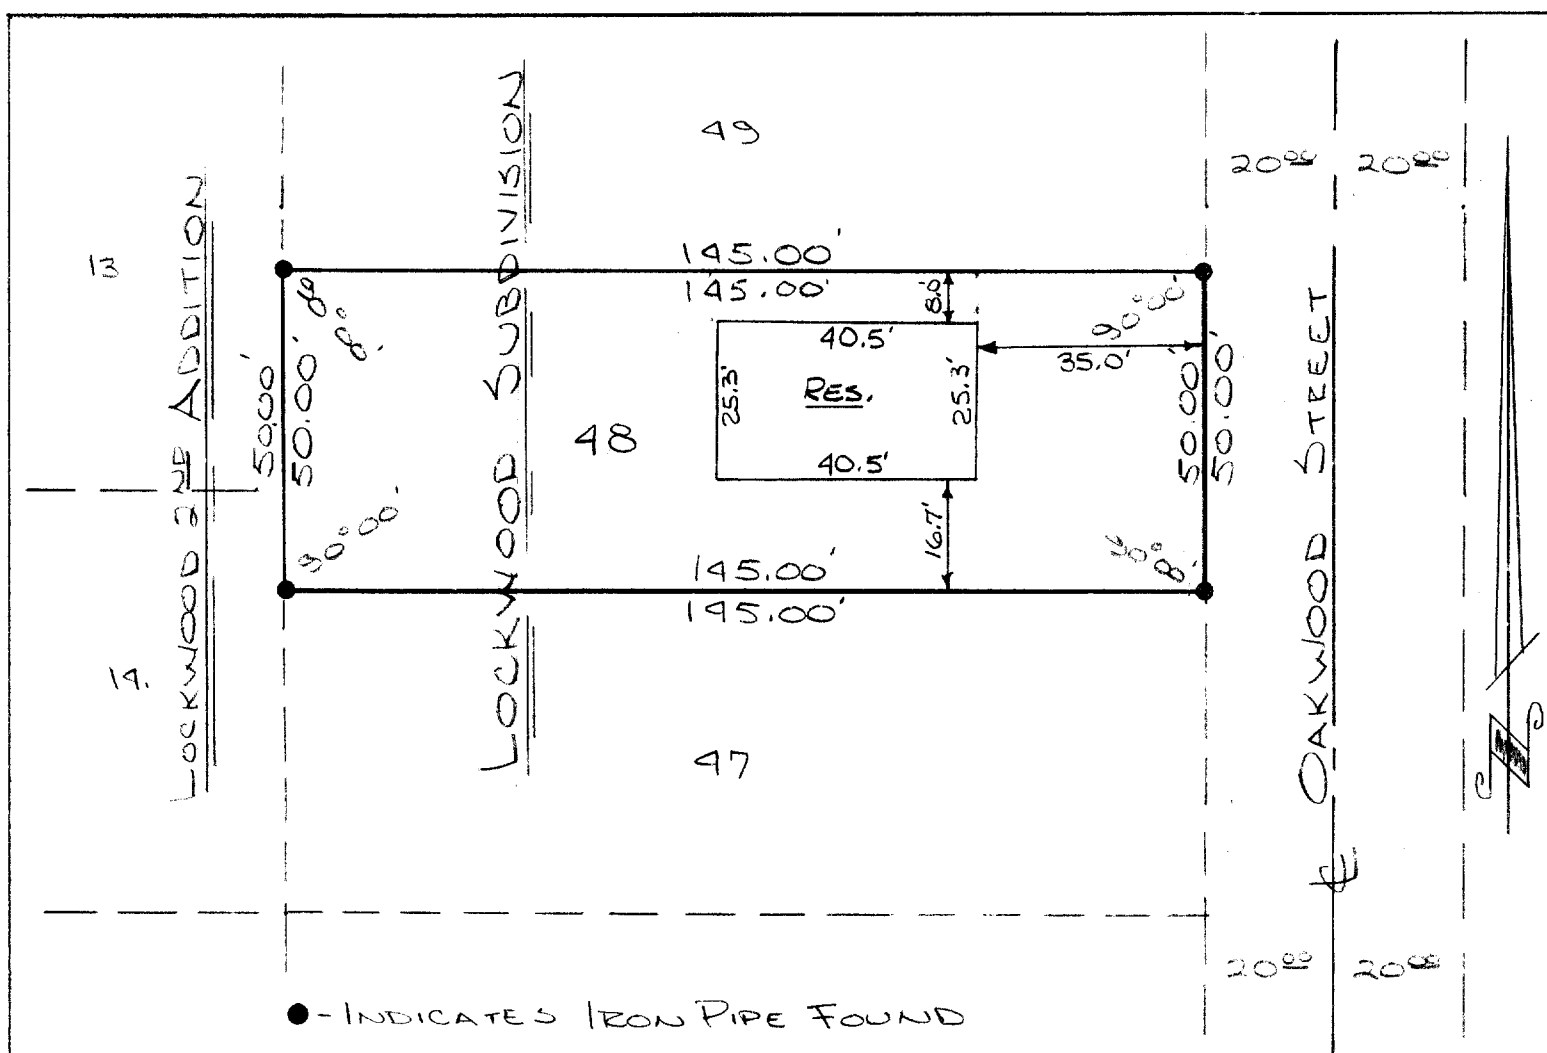

DESCRIPTION:

All of Lot number Forty-Eight (48) Lockwood Subdivision, in the Village of Williams Bay, Walworth County, Wisconsin.

CERTIFICATE:

I, James F. Biagi, surveyor, do hereby certify that I have surveyed the lands hereon described.

July 24, 1972

James F. Biagi RLS#272

RE-CERTIFICATION

November 14, 1972

Joseph M. Biagi RLS#12

