

Farris, Hansen & Associates, Inc.

7 RIDGEWAY COURT, P.O. BOX 437, ELKHORN, WISCONSIN




TEL. 414-723-2098

LOCATION: LOT 31 OF WILLABAY WOODS, A SUBDIVISION
IN THE NE 1/4 SEC. 6-1-17, VILLAGE OF
WILLIAMS BAY, WALWORTH CO., WI.

WORK ORDERED BY: CHOYCE ENTERPRISES

- MAP LEGEND
- = IRON PIPE STAKE FOUND
 - = IRON PIPE STAKE SET
 - = IRON ROD STAKE FOUND
 - = IRON ROD STAKE SET
 - = CONCRETE MONUMENT FOUND
 - (XXXXX) = RECORD DIMENSION

MAP SCALE IN FEET

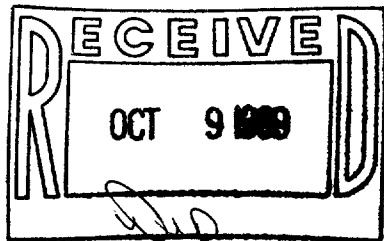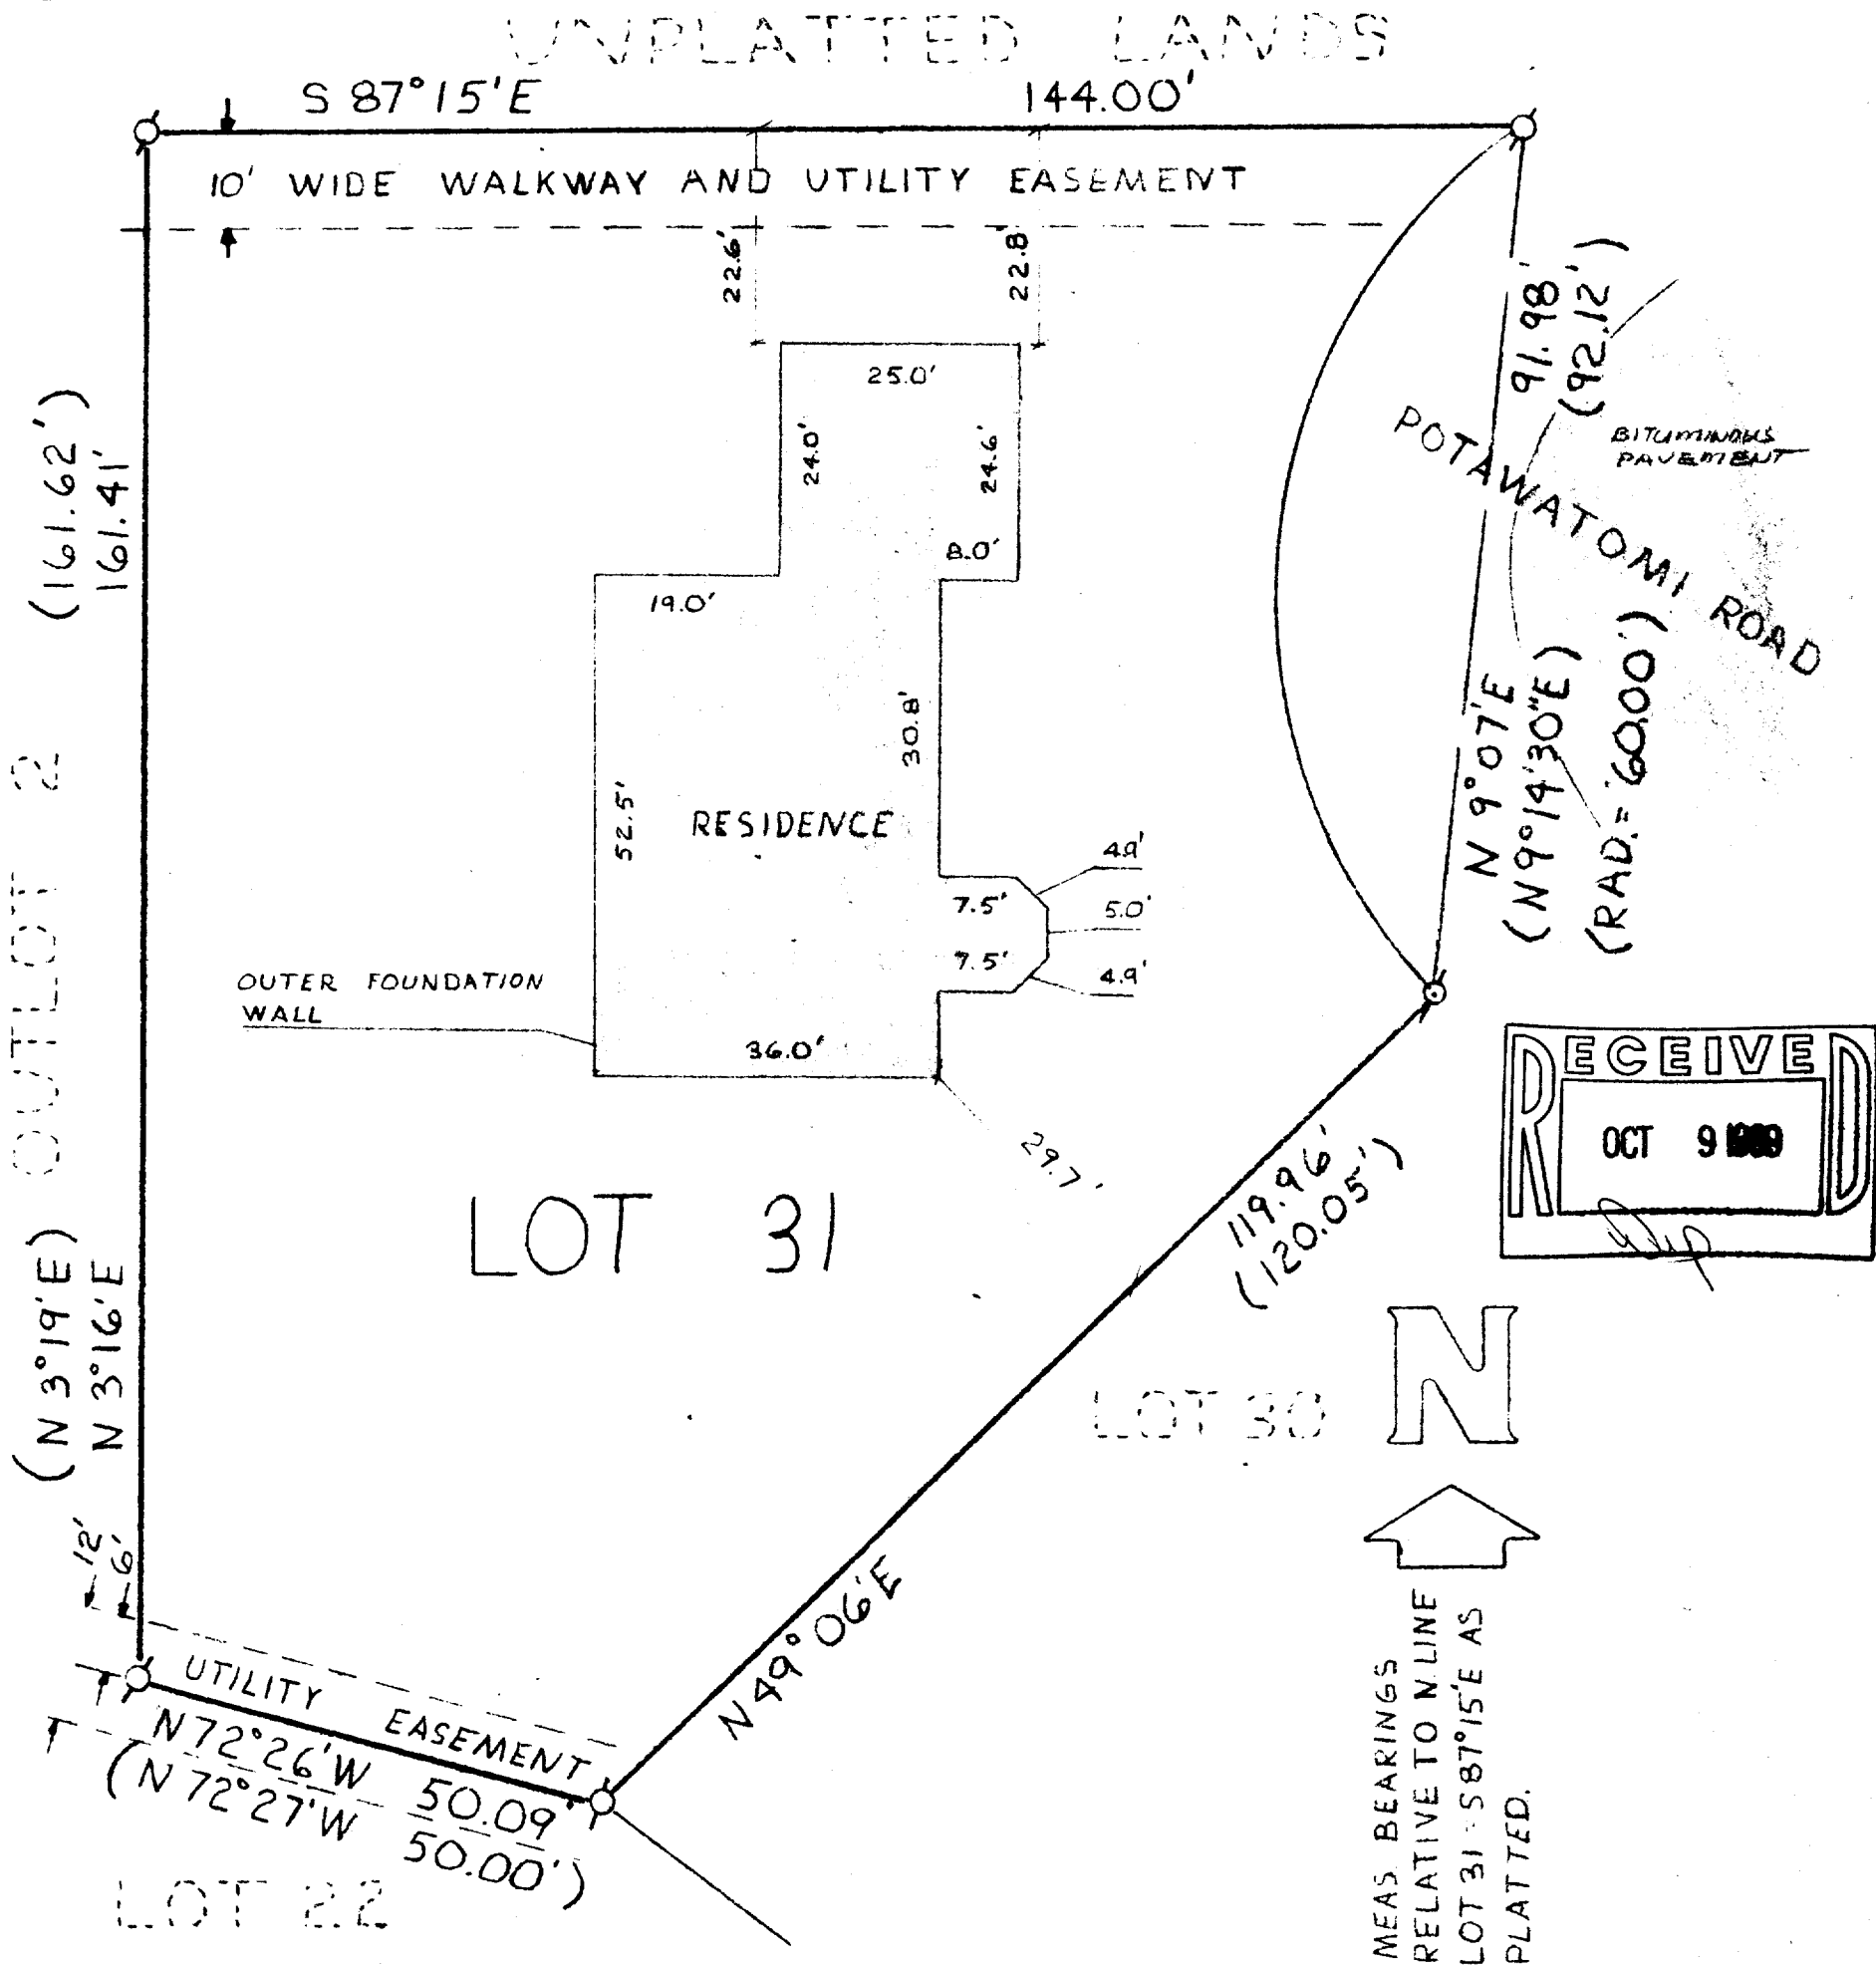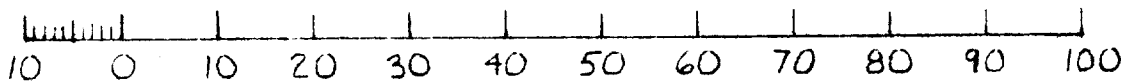


NOTE: COPIES OF THIS MAP TO WHICH THE FOLLOWING CERTIFICATE WILL APPLY ARE BLUE LINE PRINTS SHOWING SURVEYOR'S SEAL AND SIGNATURE IN BLACK INK. COPIES BY ANY OTHER MEANS MAY HAVE ALTERATIONS WHICH DO NOT REPRESENT THE SURVEYOR'S WORK PRODUCT.

I hereby certify that the above described property has been surveyed under my direction and that the above map is a true representation thereof and shows the size and location of the property and its exterior boundary dimensions and monuments. This survey is made for the use of the present owners of the property, and also those who purchase, mortgage, or guarantee the title thereto within one year from the date hereof.

DATED: 7/25/89

Robert A. Farris

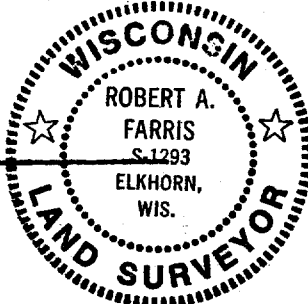

PROJ. NO. 3253