

ROBERS & FISCHER, INC.
CONSULTING ENGINEERS & LAND SURVEYORS

PHONE (414) 763-2652


116 E. CHESTNUT ST.

BURLINGTON, WIS. 53105


PLAT OF SURVEY

of

Lot 20 Lackey Brothers Subdivision to the Village of
 Williams Bay, Walworth County, Wisconsin.

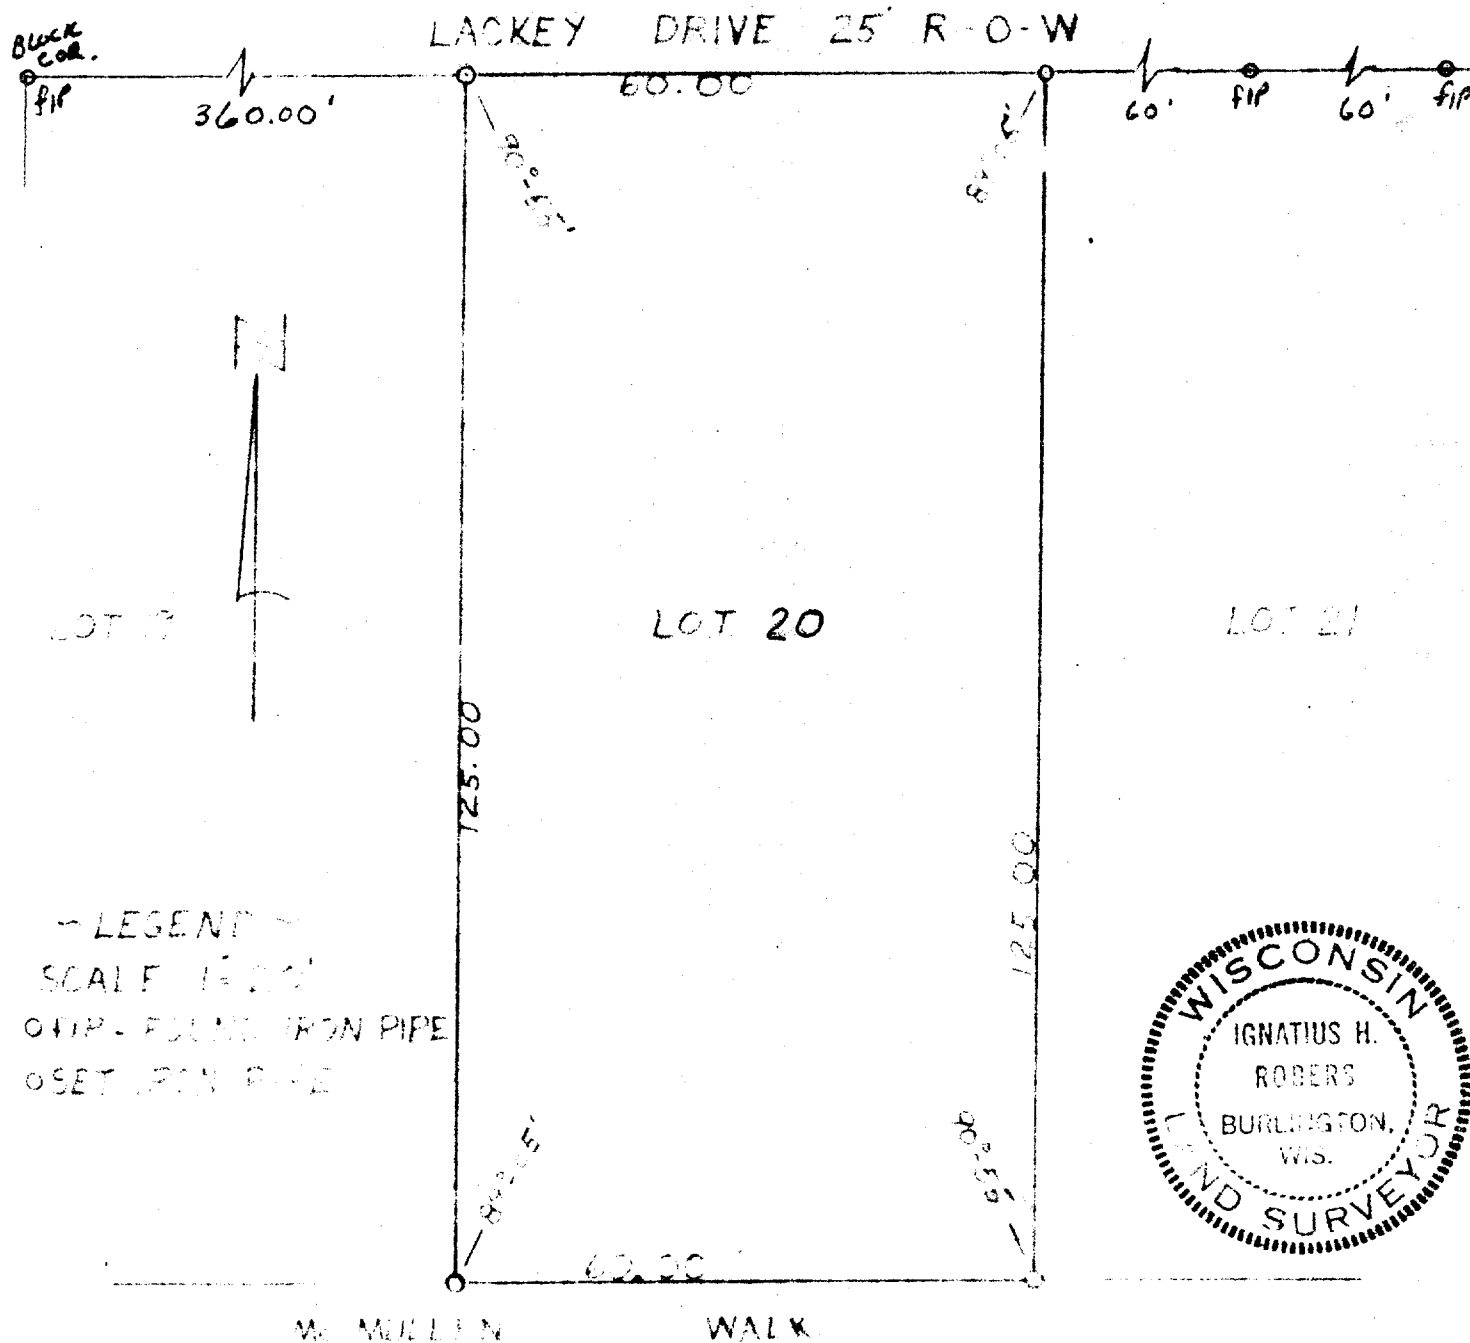

~ LEGEND ~
 SCALE 1"=20'
 O FIP - FOUND IRON PIPE
 O SET IRON PIPE

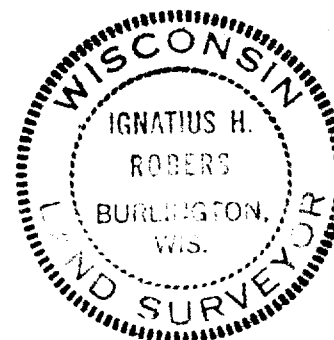

I HEREBY CERTIFY THAT WE HAVE SURVEYED THE LANDS DESCRIBED
 ABOVE ACCORDING TO OFFICIAL RECORDS AND THAT THE PLAT
 DRAWN HEREON IS A CORRECT REPRESENTATION OF SAID SURVEY.

Ignatius H. Rober
 WIS. REG. LAND SURVEYOR 500727

DATE 4-21-71

JOB NO. 11-72