


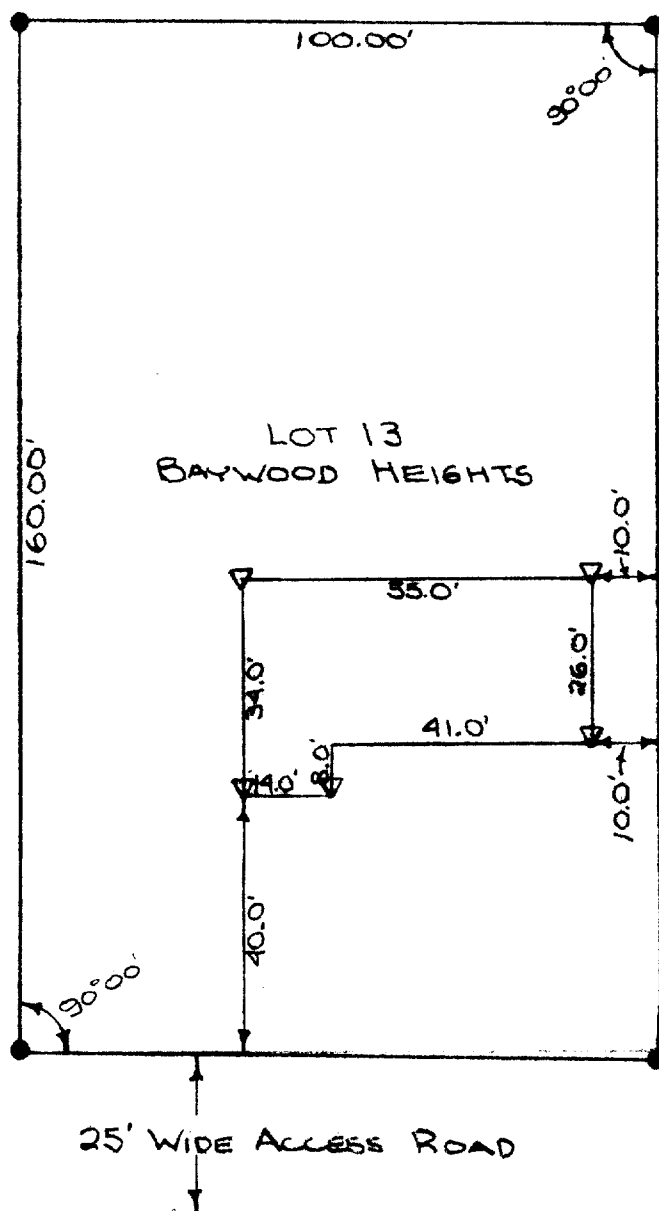

STATE HWY. "36"

DESCRIPTION: Lot 13 of Baywood Heights Subd. located in the NW₄ of Section 1, T1N, R16E, in the Village of Williams Bay, Walworth County, Wisconsin.

CERTIFICATE: I, James F. Biagi, surveyor, do hereby certify that I have surveyed the property hereon described.

DATE: June 24, 1971

James F. Biagi
James F. Biagi
Elkhorn, Wisconsin
RLS 272