


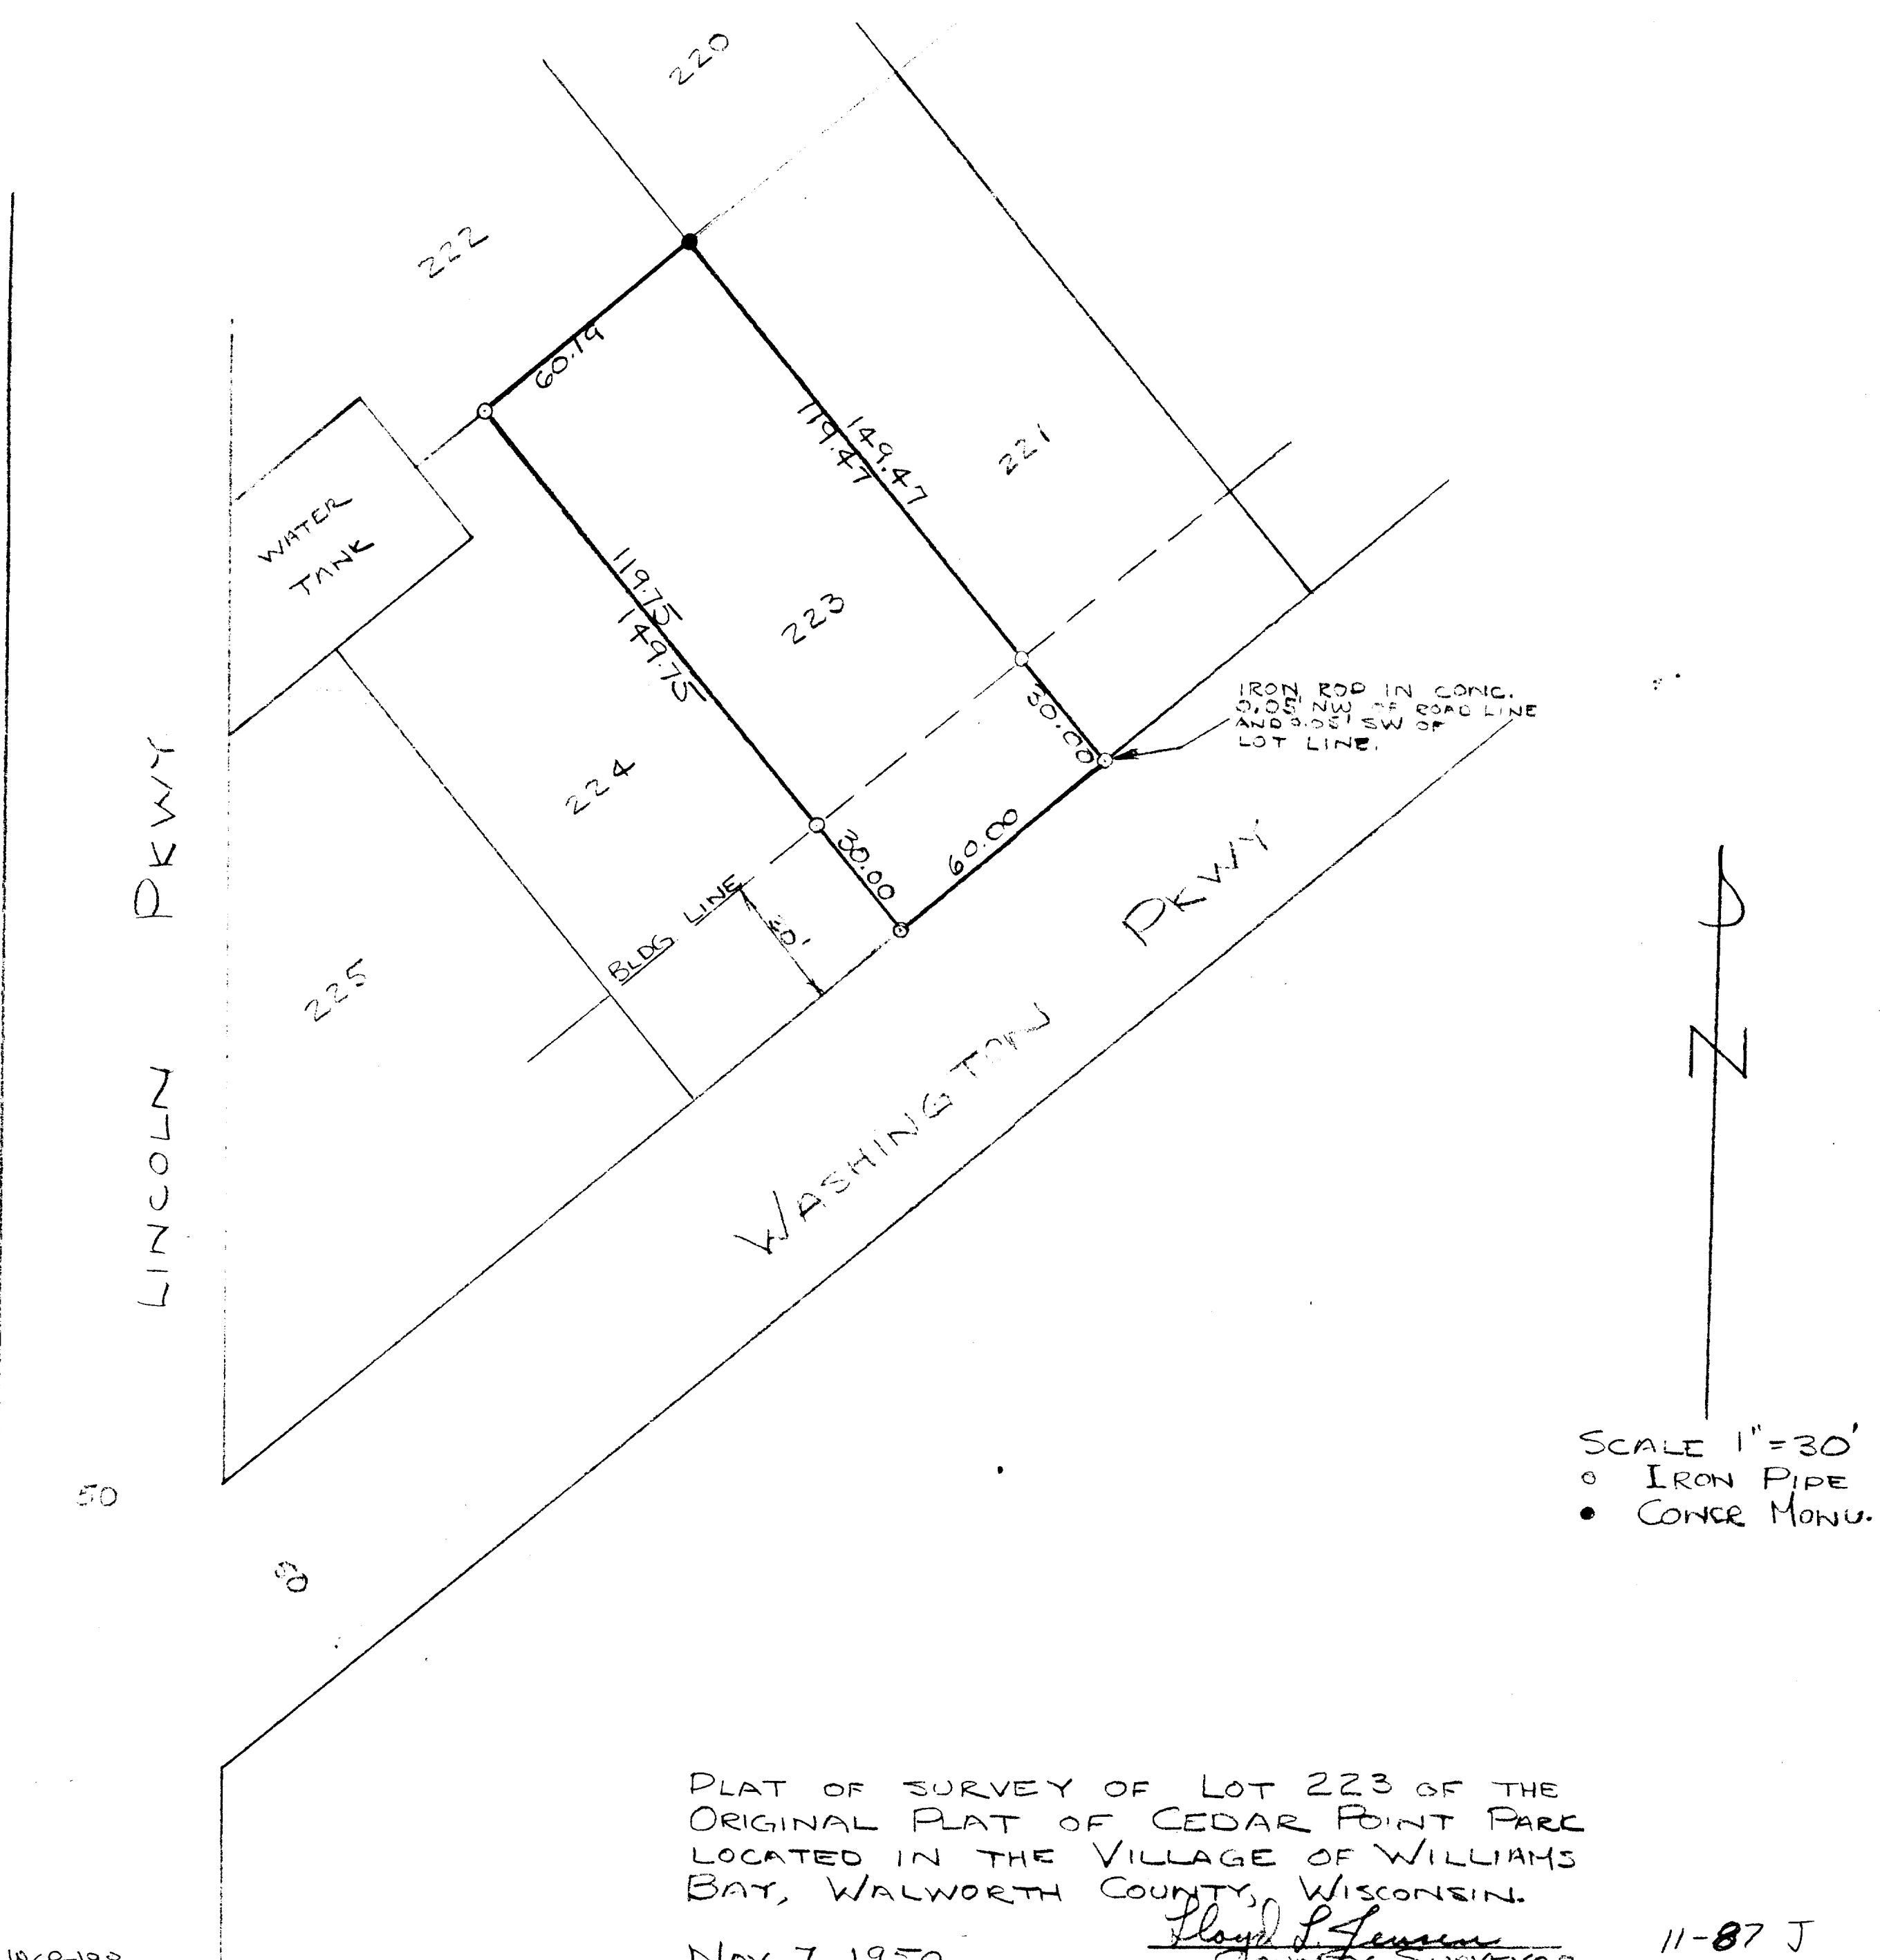

PLAT OF SURVEY OF LOT 223 OF THE
 ORIGINAL PLAT OF CEDAR POINT PARK
 LOCATED IN THE VILLAGE OF WILLIAMS
 BAY, WALWORTH COUNTY, WISCONSIN.

Nov 7, 1950

Lloyd L. Jensen
 COUNTY SURVEYOR

11-87 J