
WALWORTH COUNTY SURVEYING & MAPPING LAKE GENEVA, WISCONSIN



PLAT OF SURVEY OF

LOT 51 OF WILLABAY WOODS, LOCATED IN THE VILLAGE OF WILLIAMS BAY, WALWORTH COUNTY, WISCONSIN.

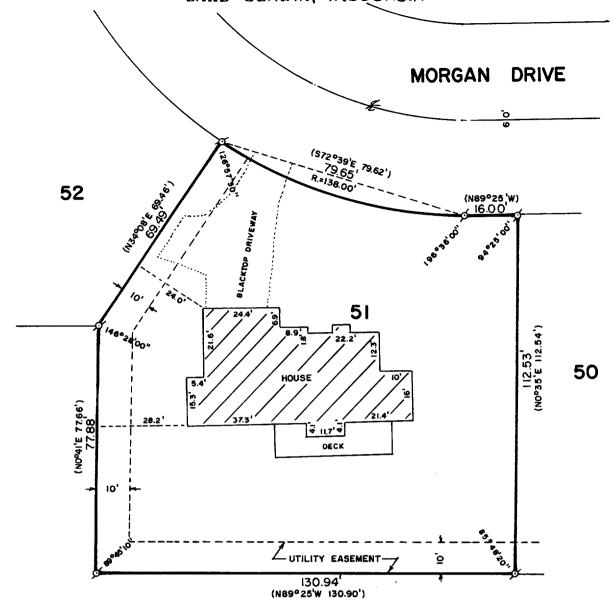

ORDERED BY: COLDWELL BANKER

GENEVA LAKES AREA REALTORS

838 MAIN STREET

LAKE GENEVA, WISCONSIN

53147

RECERTIFICATION DATE: AUG. 5, 1991



SCALE: 1"=30'

ø-IRON PIPE FOUND ()-RECORDED AS I HEREBY CERTIFY THAT I HAVE SURVEYED THE ABOVE DESCRIBED PROPERTY AND THAT THE ABOVE MAP IS A TRUE REPRESENTATION THEREOF AND 8HOWS THE SIZE AND LOCATION OF THE PROPERTY, ITS EXTERIOR BOUNDARIES, THE LOCATION OF ALL VISIBLE STRUCTURES AND DIMENSIONS OF ALL PRINCIPAL BUILDINGS THEREON, BOUNDARY FENCES, APPARENT EASEMENTS AND ROADWAYS AND VISIBLE ENCROACHMENTS, IF ANY.

THIS SURVEY IS MADE FOR THE EXCLUSIVE USE OF THE PRESENT OWNERS OF THE PROPERTY, AND ALSO THOSE WHO PURCHASE, MORTGAGE, OR GUARANTEE THE TITLE THERETO WITHIN ONE (1) YEAR FROM DATE HEREOF.

ROBERT M. BAERENWALD

WISCONSIN REGISTERED LAND SURVEYOR, S-1508

DATE JOB NO. 1671

NOTE: THIS IS NOT A CERTIFIED COPY UNLESS SEALED.

Ø11-907