



**HAROLD H. KOLB**  
 REGISTERED PROFESSIONAL LAND SURVEYOR  
 LAKE GENEVA, WISCONSIN

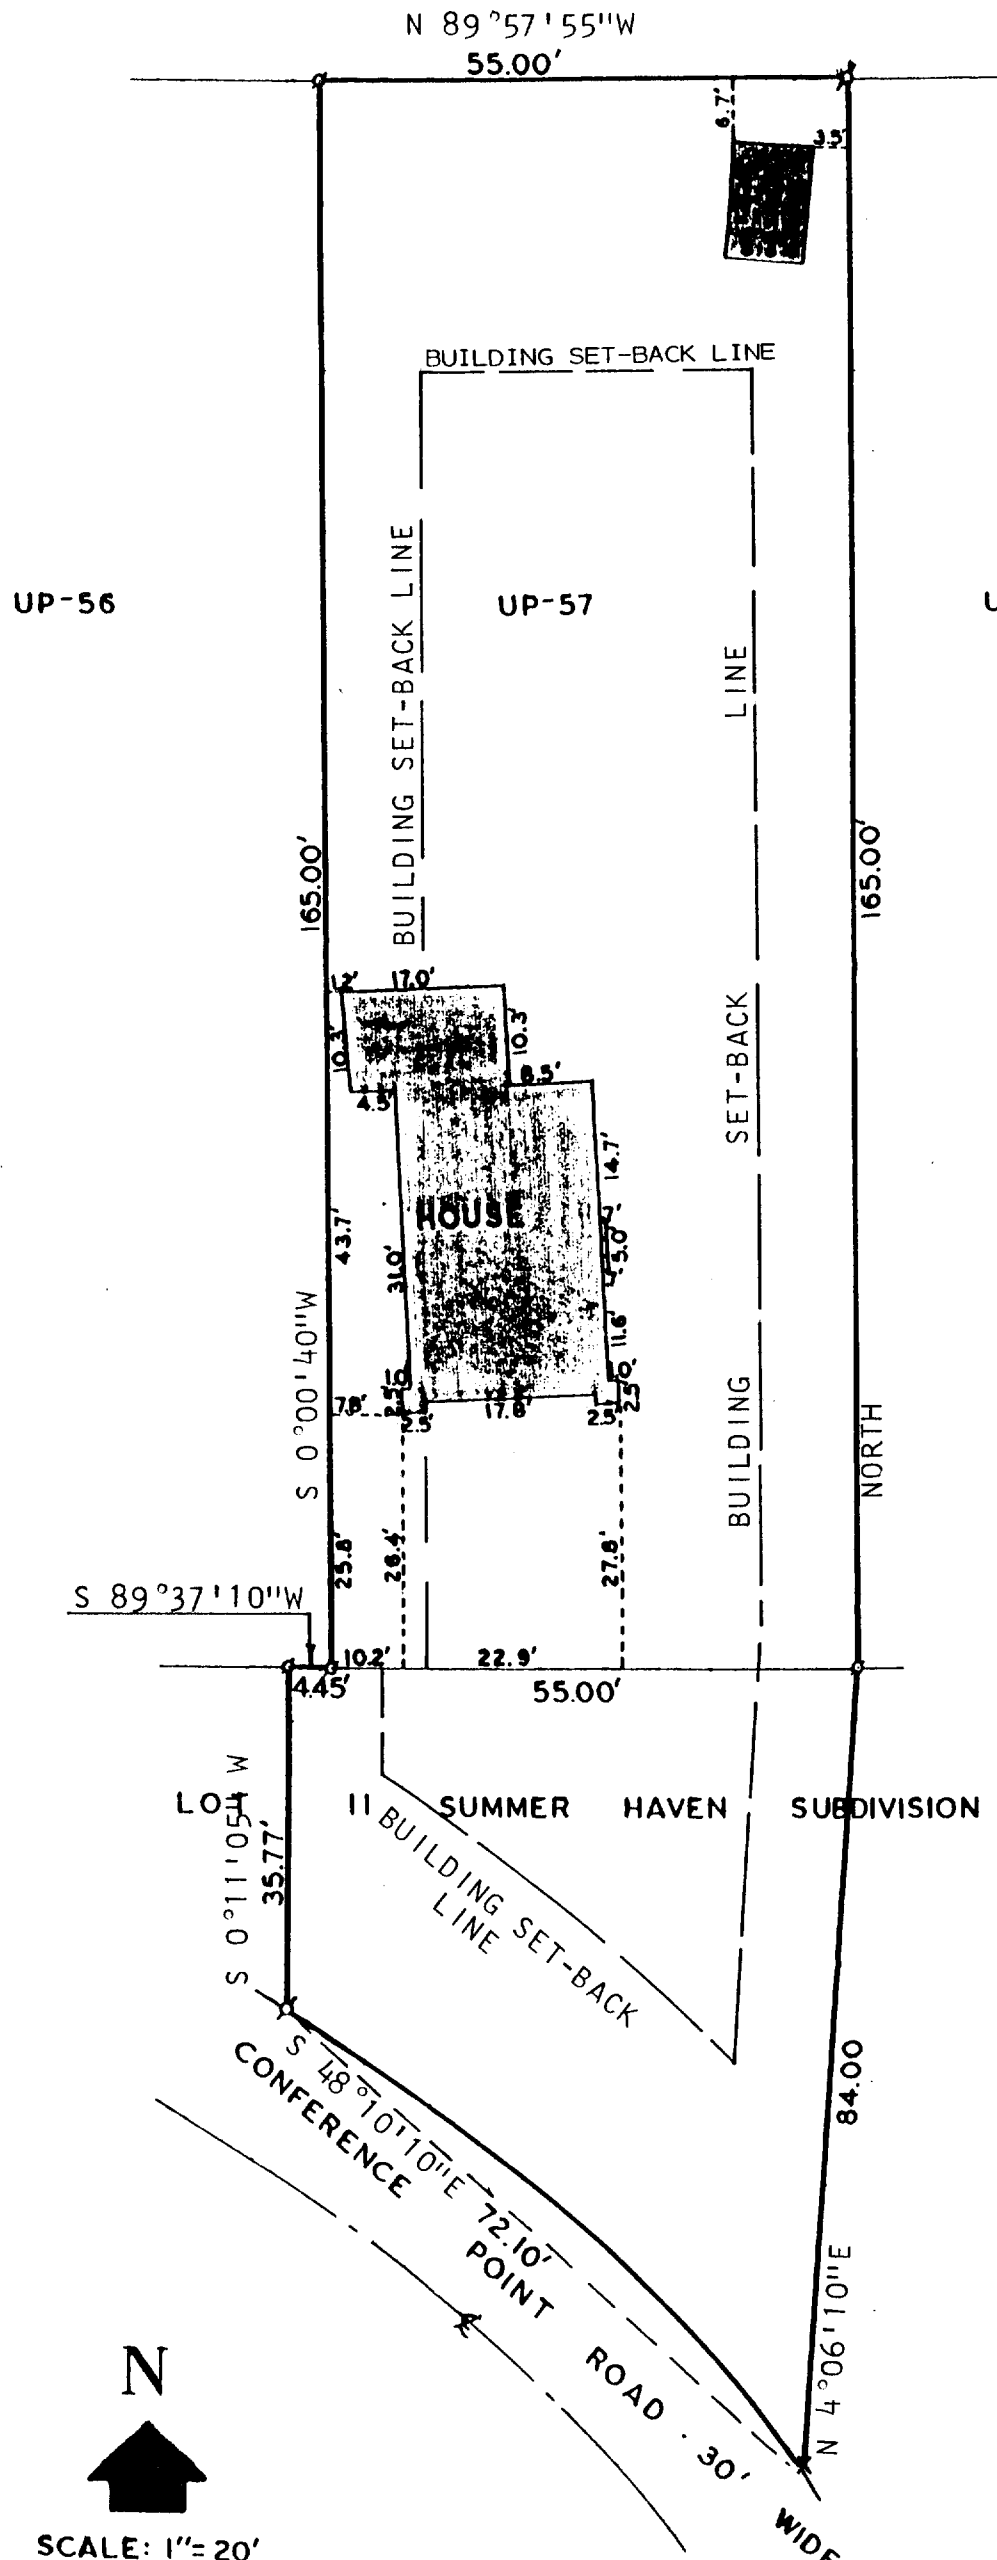

PLAT OF SURVEY OF

A PARCEL OF LAND LOCATED IN THE  
 SOUTHEAST 1/4 OF SECTION 1, T1N,  
 R16E, AND PART OF LOT 11 OF SUMMER  
 HAVEN SUBDIVISION LOCATED IN THE  
 VILLAGE OF WILLIAMS BAY, WALWORTH  
 COUNTY, WISCONSIN.

OWNER: CARL NOVAK  
 505 N. MAPLE ST.  
 PROSPECT HEIGHTS, IL. 60070

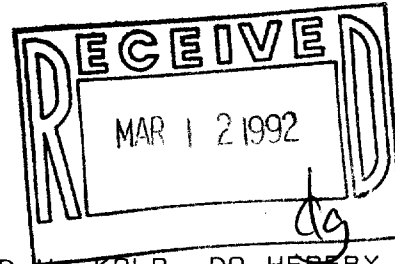

I, HAROLD H. KOLB, DO HEREBY CERTIFY  
 THAT I HAVE SURVEYED THE PROPERTY  
 HEREON DESCRIBED ACCORDING TO THE  
 OFFICIAL RECORDS AND THAT THE PLAT  
 HEREON IS A CORRECT REPRESENTATION  
 OF THE LOT LINES TO THE BEST OF MY  
 KNOWLEDGE AND BELIEF.  
 SURVEY NOT VALID UNLESS SURVEYOR'S SIGNATURE  
 IS IN RED.

HAROLD H. KOLB  
 WISCONSIN REGISTERED LAND SURVEYOR, S-187  
 DATE: OCTOBER 30, 1991

N  
  
 SCALE: 1" = 20'  
 LEGEND

- φ — IRON PIPE FOUND
- — IRON PIPE PLACED
- — CONCRETE MONUMENT
- x — SPIKE

