


HAROLD H. KOLB


REGISTERED PROFESSIONAL LAND SURVEYOR
LAKE GENEVA, WISCONSIN

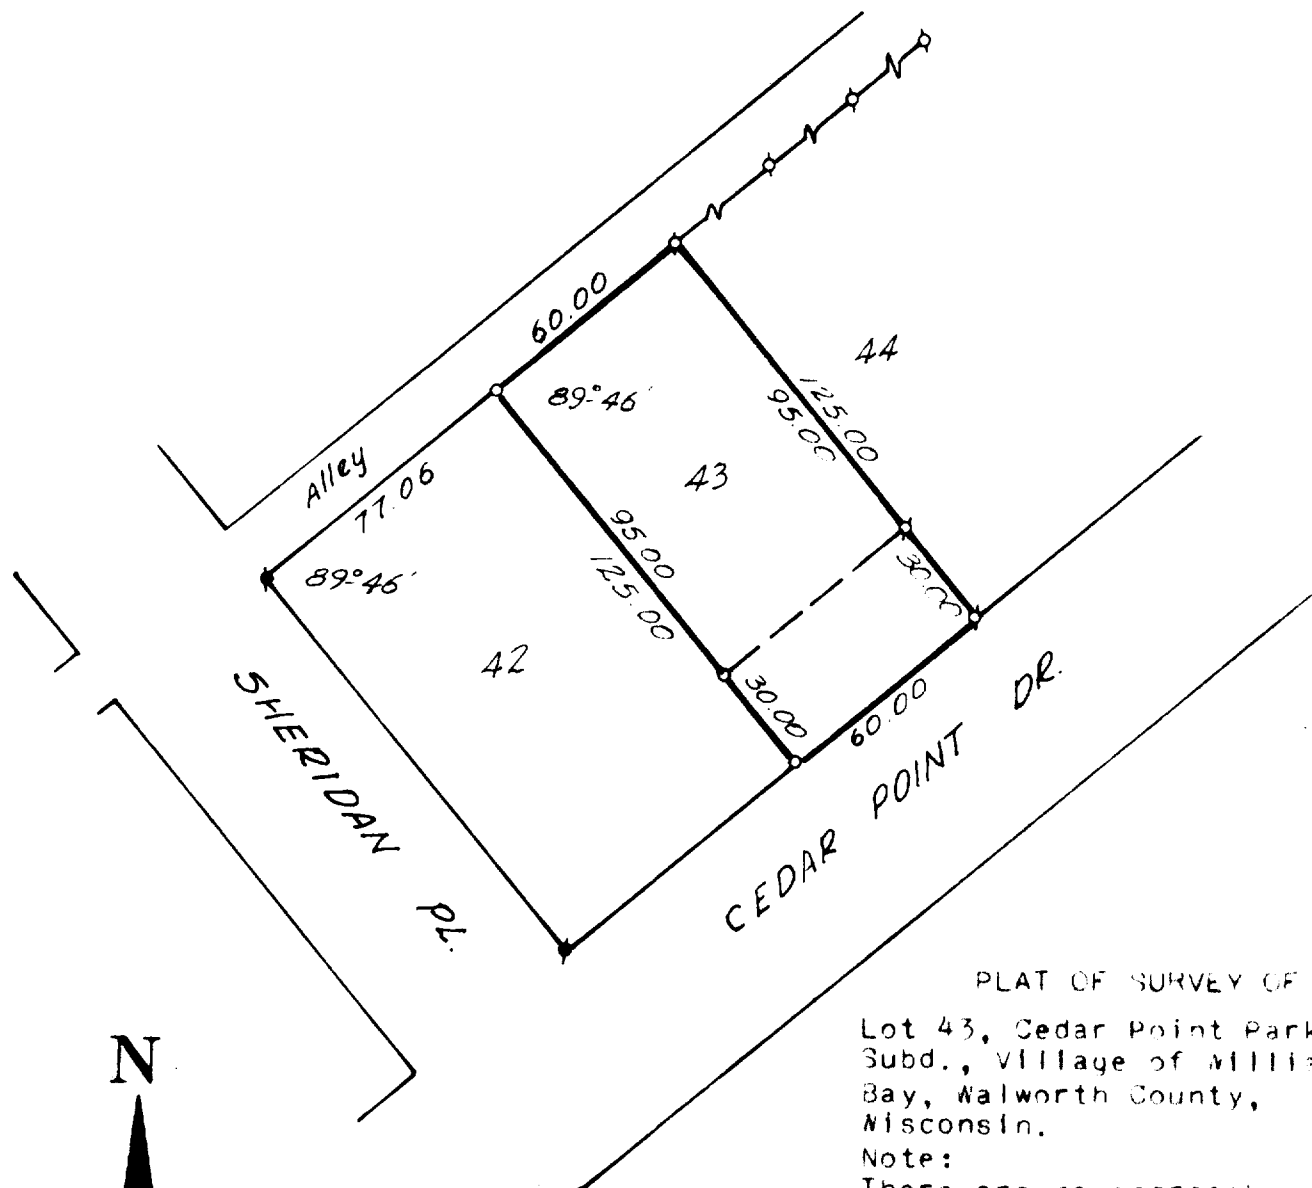

N

LEGEND

- X - IRON PIPE FOUND
 - O - IRON PIPE PLACED
 - - CONCRETE MONUMENT
 - X - SPIKE
- SCALE - 1" = 50'

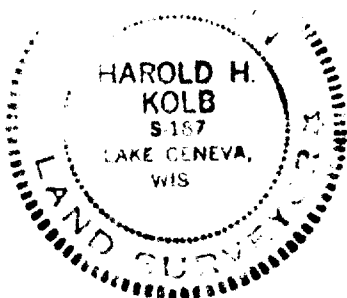

PLAT OF SURVEY OF

Lot 43, Cedar Point Park
Subd., Village of Williams
Bay, Walworth County,
Wisconsin.

Note:

There are no encroachments
on the above described
property.

I, HAROLD H. KOLB, DO HEREBY CERTIFY THAT I HAVE
SURVEYED THE PROPERTY HEREON DESCRIBED ACCORDING
TO THE OFFICIAL RECORDS, AND THAT THE PLAT HEREON
IS A CORRECT REPRESENTATION OF THE LOT LINES.

Harold H. Kolb

HAROLD H. KOLB
WISCONSIN REGISTERED LAND SURVEYOR, S-187
DATE OCT. 23, 1969

11-93