


SCALE 1" = 20'

● = CONCR MONU

○ = IRON PIPE

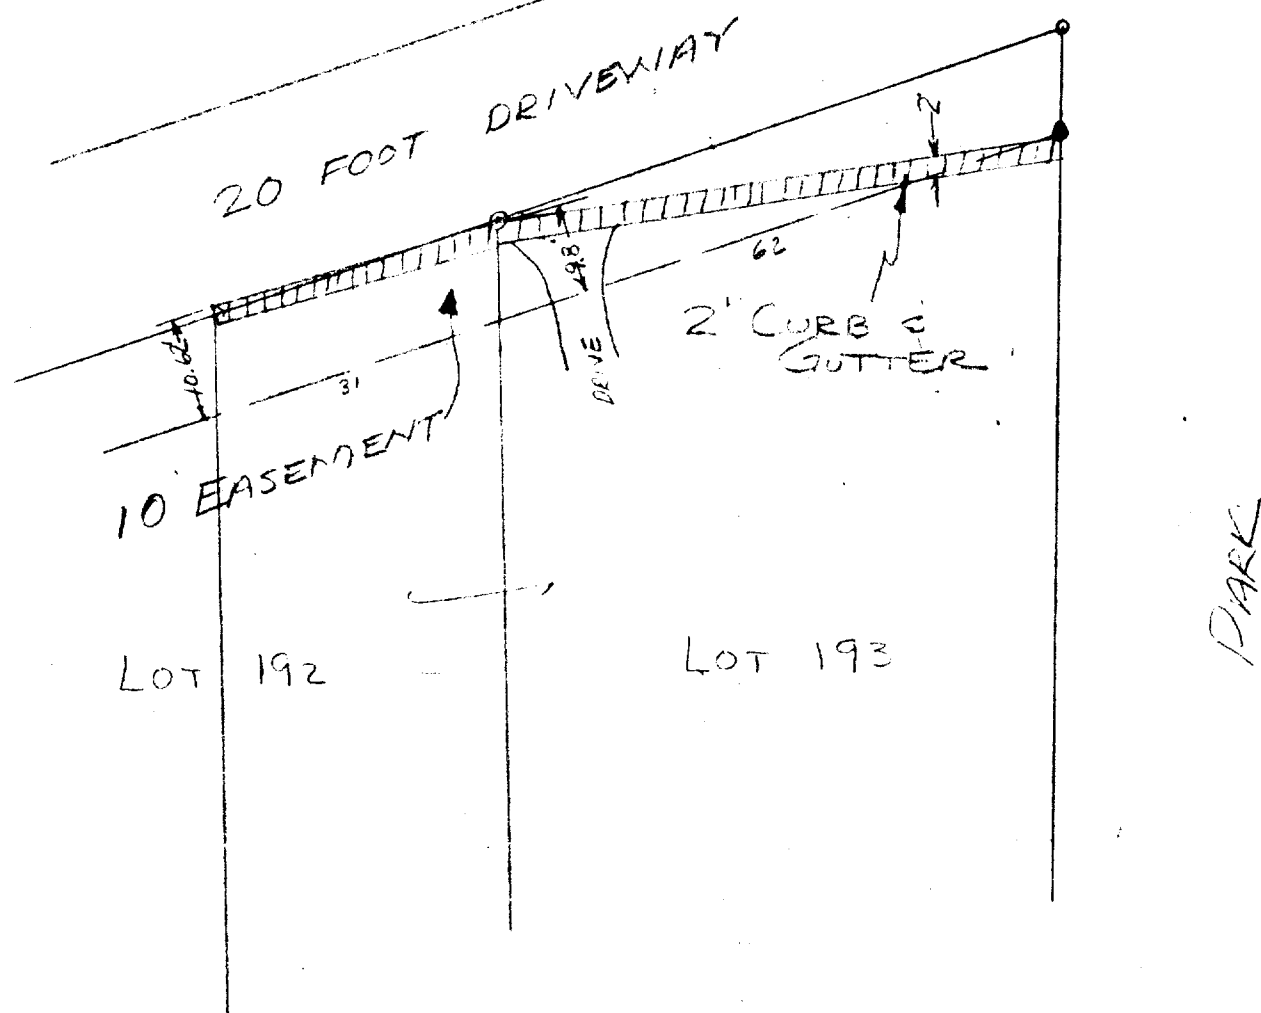

SKETCH OF 20' DRIVEWAY AND 10'
EASEMENT EAST OF LOTS 192 & 193
OF THE 2ND ADDITION TO CEDAR POINT
PARK, WILLIAMS BAY, WILLOW RIVER CO., WIS
JULY, 1950

V. E. Johnson
SURVEYOR

11-95