


PLAT OF SURVEY LOT 10 AND SOUTH 9 FEET LOT 11 BLOCK 2 ADDITION NO. 1, VILLAGE OF WILLIAMS BAY, WALWORTH CO., WIS.

10 0 10 20 30 40 50 60 70 80 90 100

MAP SCALE IN FEET

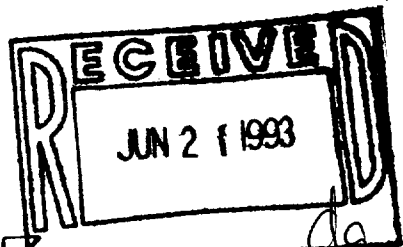

N

A-B - DUE EAST

Ø = FOUND IRON PIPE SURVEY STAKE
O = SET IRON PIPE STAKE 1"X24"
(***) = RECORD DIMENSION


----- = OVERHEAD UTILITY WIRES

I hereby certify that I have surveyed the above described property and that the above map is a true representation thereof and shows the size and location of the property, its exterior boundaries, the location of all visible structures and dimensions of all principal buildings thereon, boundary fences, apparent easements, roadways and visible encroachments, if any. This survey is made for the use of the present owners of the property, and also those who purchase, mortgage, or guarantee the title thereto within one (1) year from the date hereof.


Peter S. Gordon

DATED 5/18/1993

PARRIS, HANSEN & ASSOCIATES, INC.
7 Ridgeway Court - P.O. Box 487
Elkhorn, Wisconsin
414-723-2098

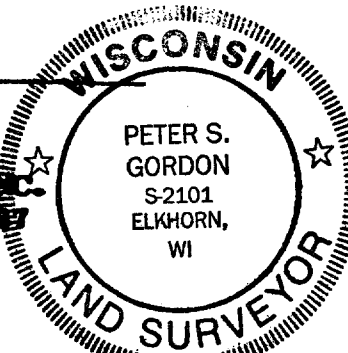

PROJECT NO. 2445

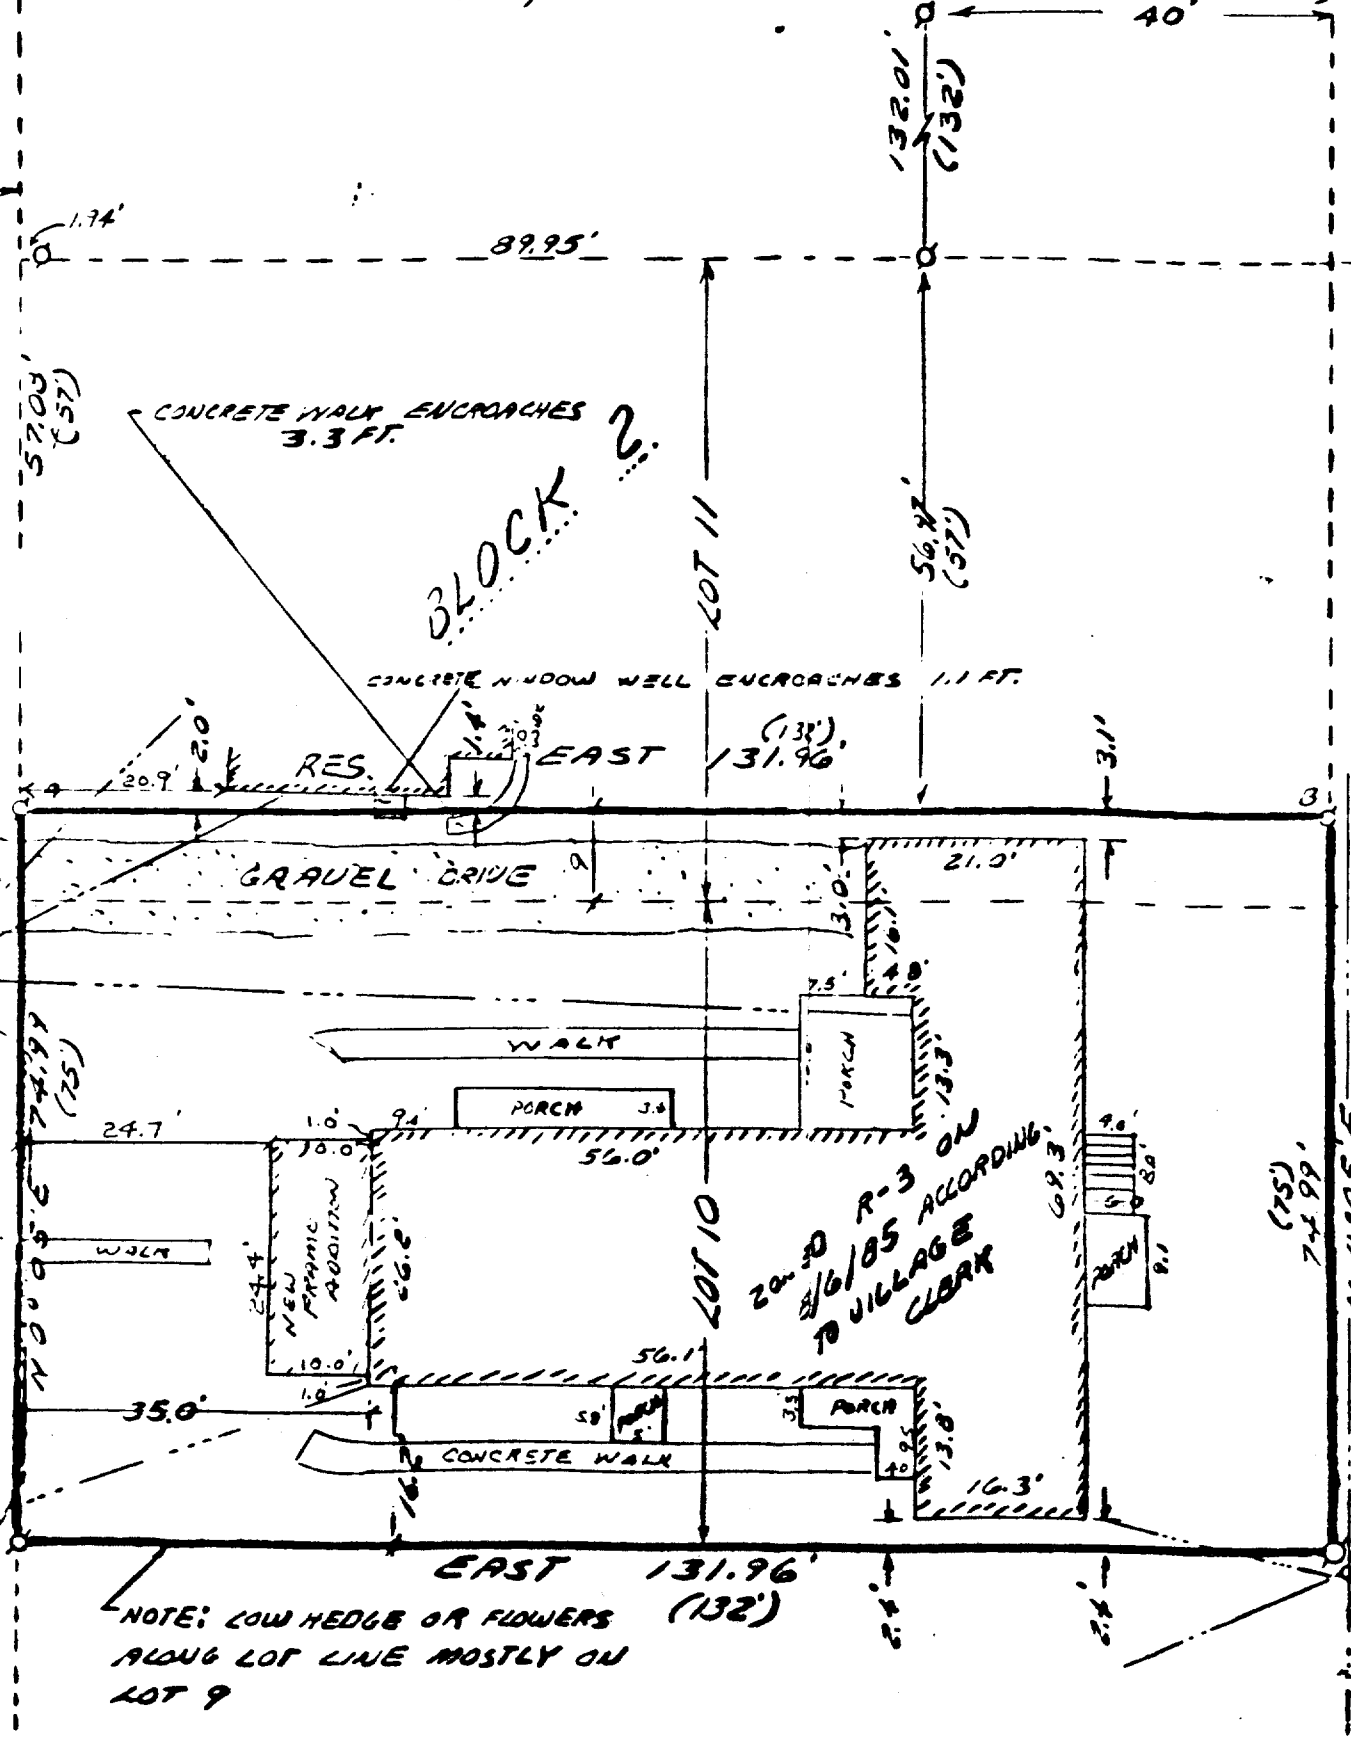

NOTE: LOW HEDGES OR FLOWERS
ALONG LOT LINE MOSTLY ON
LOT 9

Block 2

ELMHURST COURT

GRAVEL DRIVE

WALK

PORCH

CONCRETE WALK

GRAVEL DRIVE

WALK

PORCH

CONCRETE WALK

GRAVEL DRIVE

WALK

PORCH