


SPRING ST.

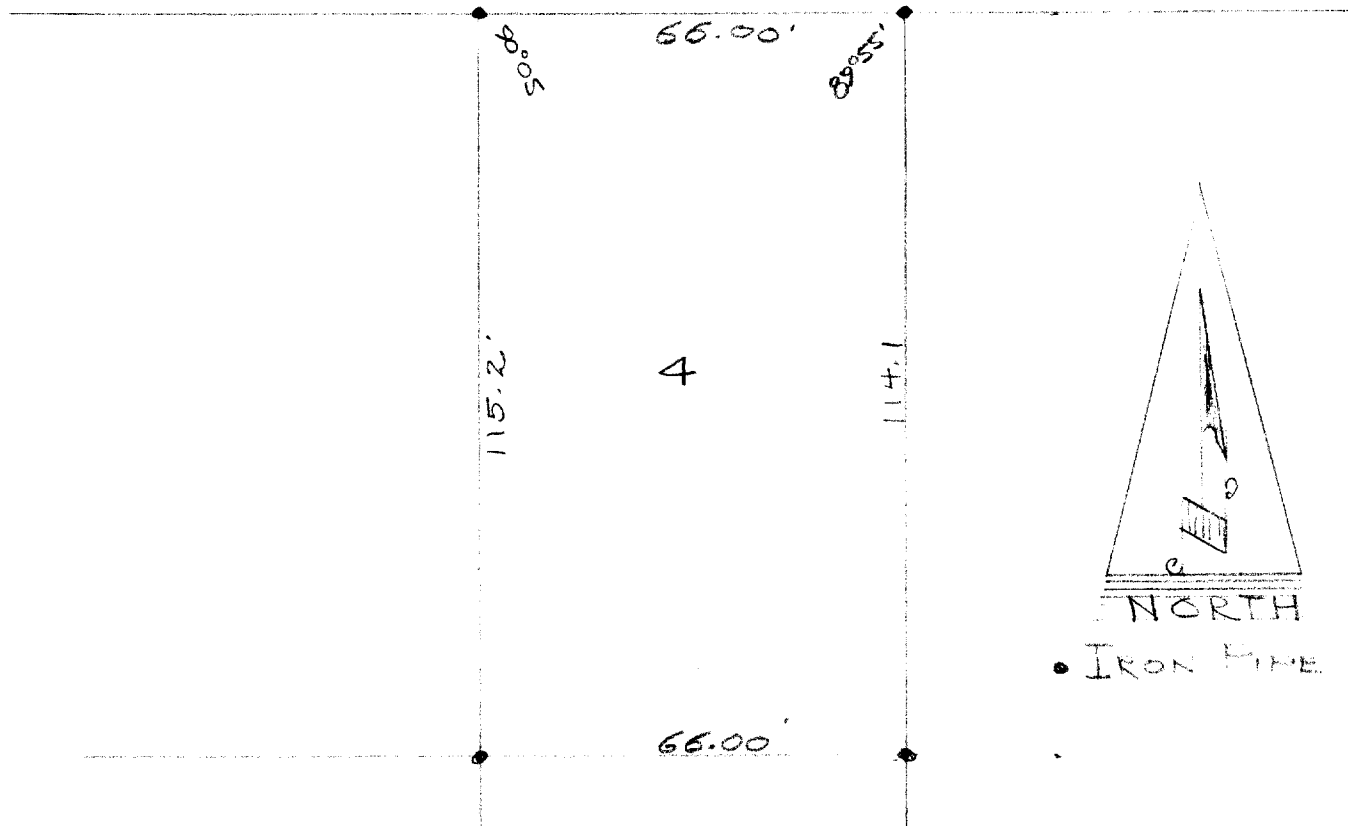

DESCRIPTION:

Lot 4, Johnson's Addition to the Village of Williams Bay, Walworth County, Wisconsin.

CERTIFICATE:

I, James F. Biagi, Surveyor do hereby certify that I have surveyed the property hereon described.

Dated August 7th 1964.

James F. Biagi
 James F. Biagi, RLS 272
 Elkhorn, Wisconsin.

