



DO NOT Photocopy

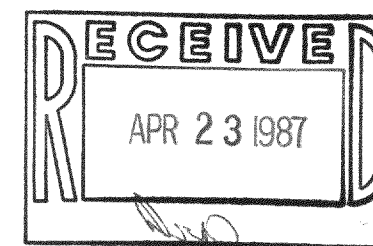

PLAT OF SURVEY

-of-

lots 5, 6, & 7 OF CEDAR POINT SUBDIVISION, LOCATED IN SECTIONS 5 & 6, TOWN 1 NORTH, RANGE 17 EAST, VILLAGE OF WILLIAMS BAY, WALWORTH COUNTY, WISCONSIN.

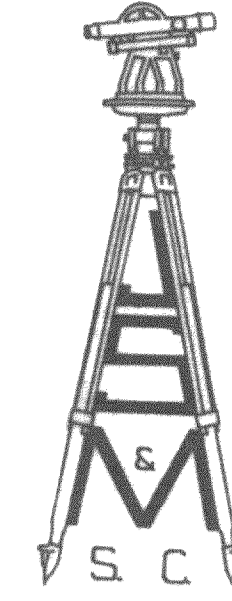


SURVEYED FOR: MODERMOTT, WILL. & EMERY
111 WEST MADRIDE STREET
CHICAGO, ILLINOIS. 60603-4067

SURVEYED BY: JENSEN SURVEYING & MAPPING S.C.
45 SOUTH WISCONSIN STREET P.O. BOX 322
ELKHORN, WISCONSIN. 53121
(414) 723-3434

MAPPING DATE: JANUARY 20, 1987

CEDAR POINT DRIVE 50' WIDE

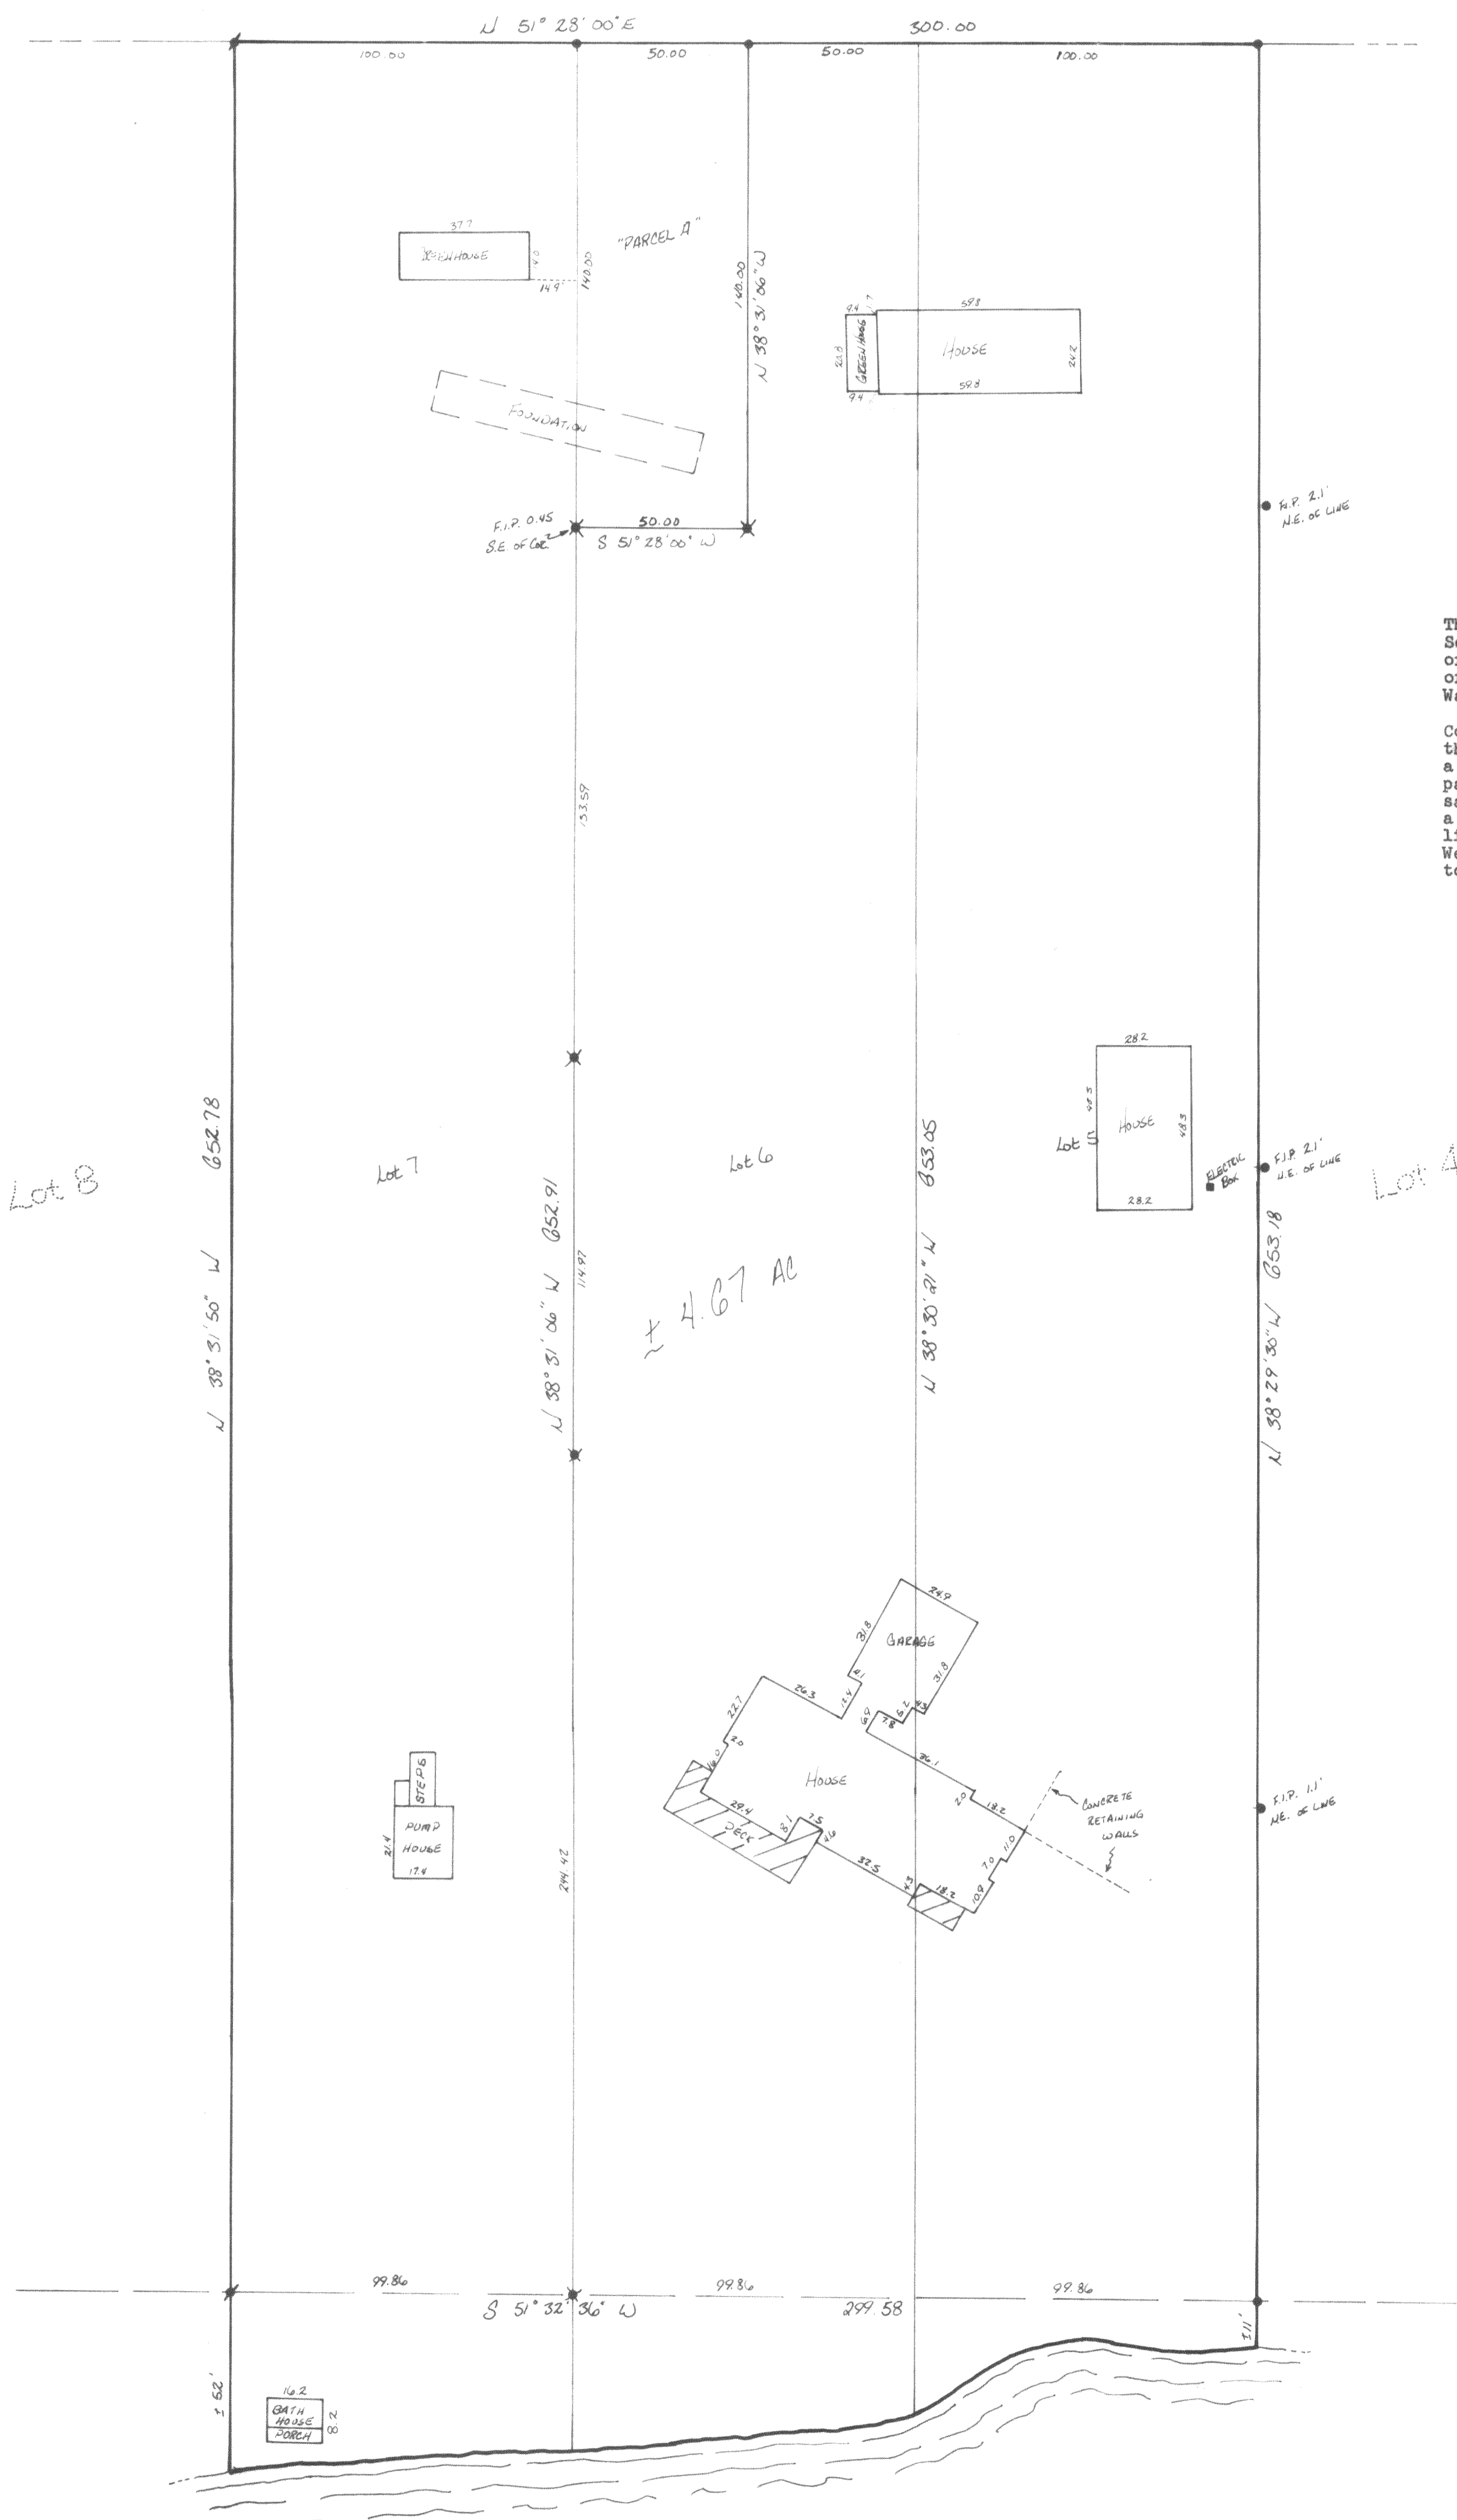


LEGAL DESCRIPTION OF "PARCEL A"

EXHIBIT A

That part of Lot 6 in Cedar Point Subdivision, in Sections 5 and 6, Township 1 North, Range 17, East of the 4th P.M., and lying and being in the Village of Williams Bay and in the Town of Linn, County of Walworth and State of Wisconsin, described as follows;

Commencing at the Northwest corner of said Lot 6; thence Easterly along the Northerly line of said Lot 6 a distance of 50 feet; thence Southerly along a line parallel to and equidistant from the Westerly line of said Lot 6 a distance of 140 feet; thence Westerly along a line parallel to and equidistant from the Northerly line a distance of 50 feet; thence Northerly along the Westerly line of said Lot 6 a distance of 140 feet to the point of beginning.

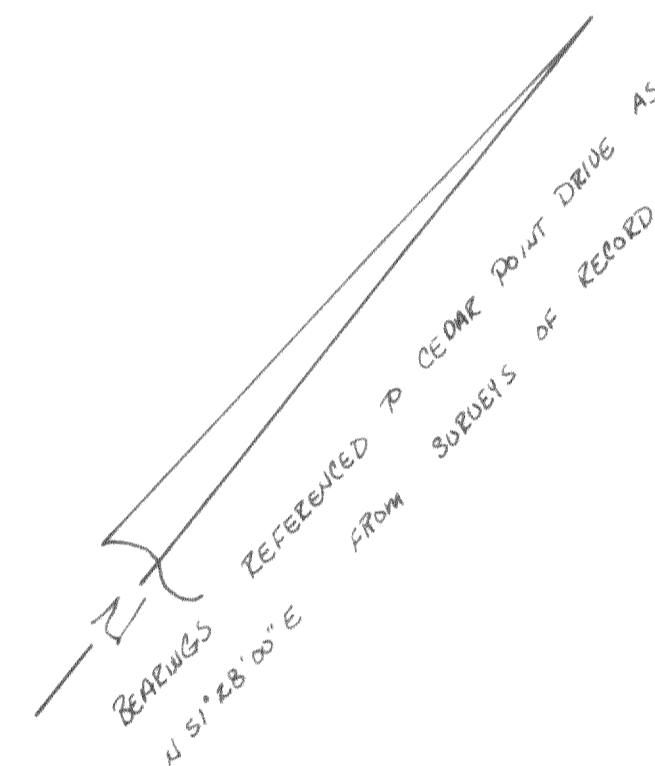

SCALE: 1" = 30'

LEGEND

- FOUND IRON PIPE
- ★ SET IRON PIPE
- ✱ FOUND IRON END

Copyright © 1987 by Jensen Surveying & Mapping S.C.
All rights reserved. No part of this survey plat may be reproduced or transmitted in any form by any means - graphic, electronic, or mechanical, including photocopying, tracing, or information storage and retrieval systems - without permission in writing from Thomas P.A. Jensen, Jensen Surveying & Mapping S.C.

I, Robert L. Meadows Jr., Wisconsin Registered Land Surveyor, do hereby certify that this survey was performed by me, or under my direction, in full compliance with the owner's/agent's instructions and chapter A-E 3 of the Wisconsin Administrative Code "Minimum Standards For Property Surveys"; and that this map is an accurate representation thereof to the best of my knowledge and belief.

Robert L. Meadows Jr. S-1801
Jensen Surveying & Mapping S.C.
45 S. Wisconsin St.
Elkhorn, Wisconsin. 53121
(414) 723-3434

Note: This survey plat is not certified unless signed and sealed in red ink.

GENEVA LAKE

1987.008

1987.008 X