

# FARRIS, HANSEN & ASSOCIATES, INC.

7 RIDGEWAY COURT, P.O. BOX 437  
ELKHORN, WISCONSIN 53121

PLAT OF SURVEY

PHONE:  
FAX:

(414) 723-2098  
(414) 723-5888


LOCATION: LOT 61 OF WILLABAY WOODS  
SEC. 6, T. 1 N., R. 17 E.  
VILLAGE OF WILLIAMS BAY  
WALWORTH COUNTY, WI

WORK ORDERED BY: JOHN & JOY NOONAN  
533 WISWELL DRIVE  
WILLIAMS BAY, WI

## MAP LEGEND

- - IRON PIPE STAKE FOUND
- - IRON PIPE STAKE SET
- - IRON ROD STAKE FOUND
- - IRON ROD STAKE SET
- - CONCRETE MONUMENT FOUND
- - RECORD DIMENSION



(XXXXX)

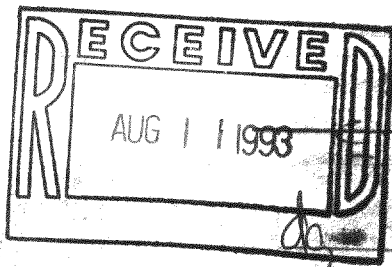

WISWELL DRIVE

BITUMINOUS

FAD BENT  
REPLACED  
W/IRON ROD STAKE

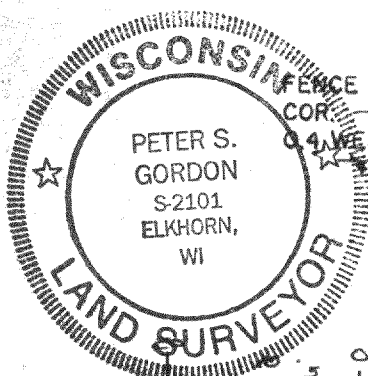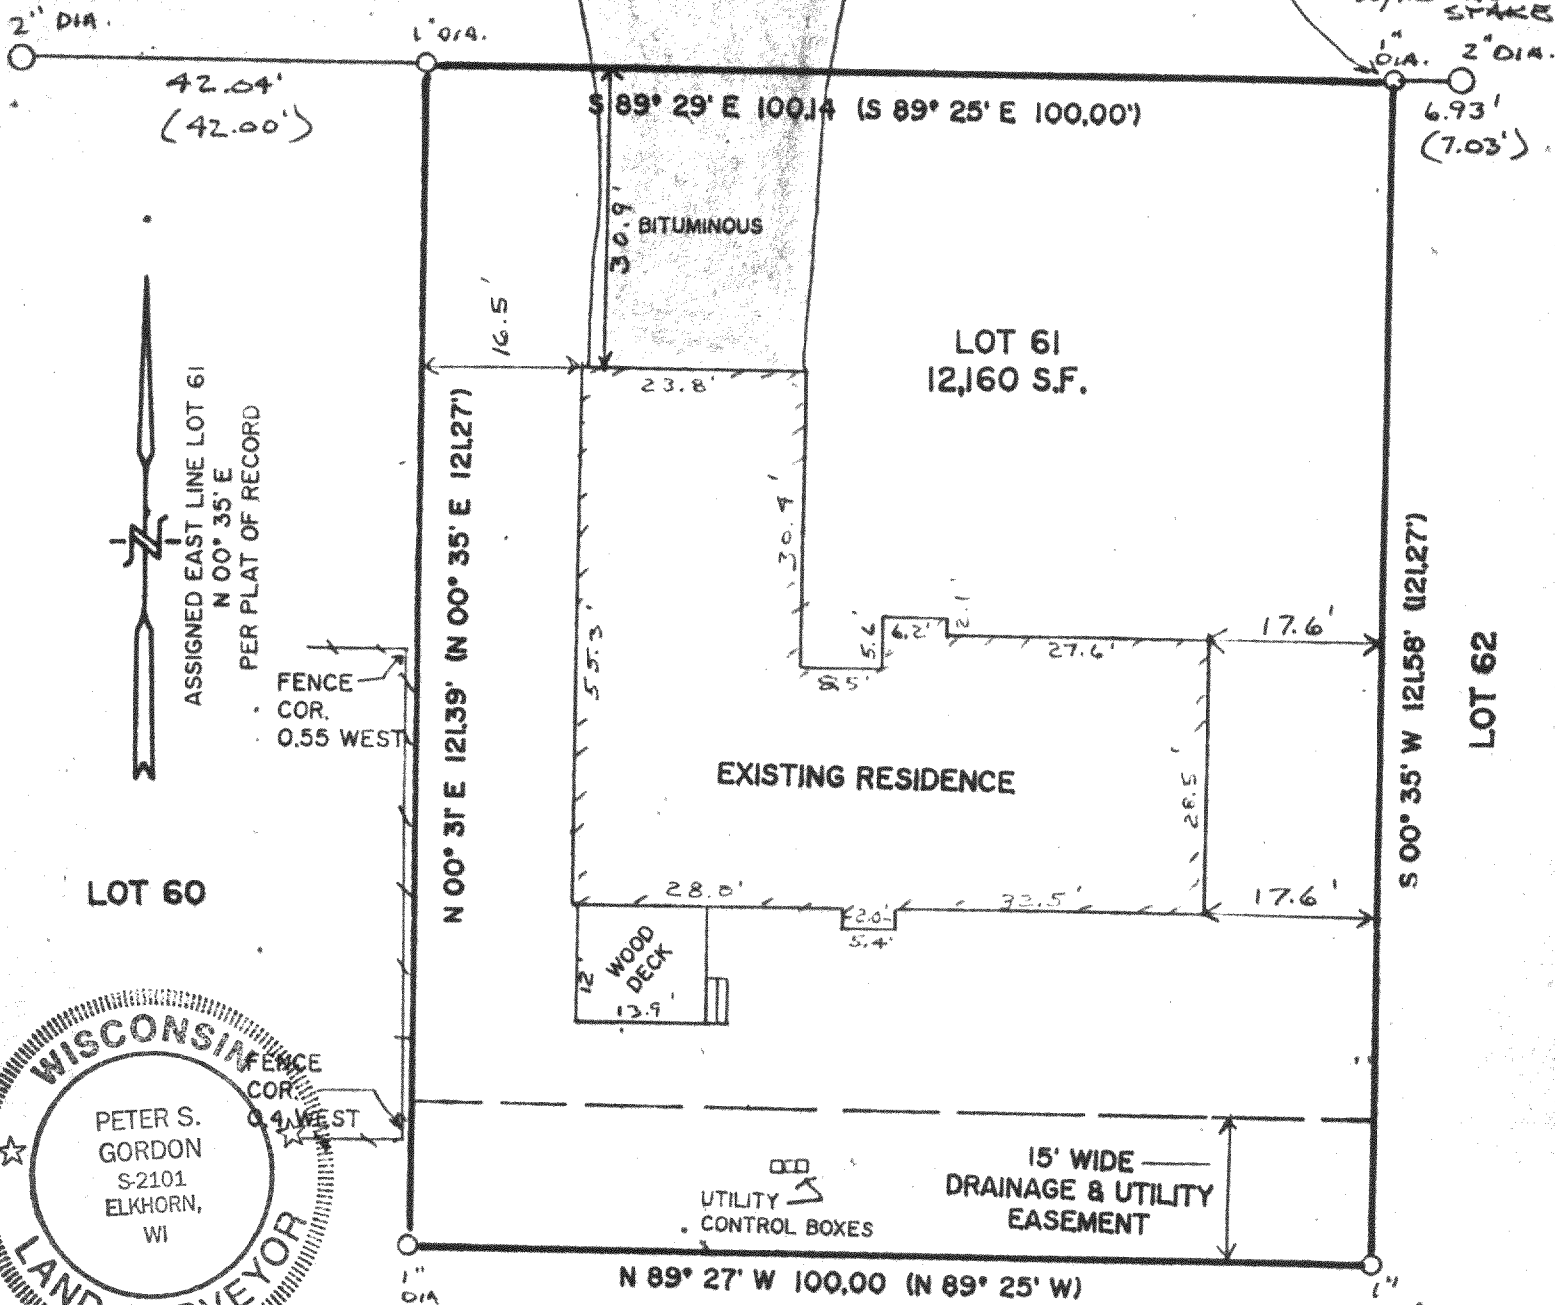

NOTE: COPIES OF THIS MAP TO WHICH THE FOLLOWING CERTIFICATE WILL APPLY ARE BLUE LINE PRINTS SHOWING SURVEYOR'S ORIGINAL SEAL AND SIGNATURE IN BLACK INK. COPIES BY ANY OTHER MEANS MAY HAVE ALTERATIONS WHICH DO NOT REPRESENT THE SURVEYOR'S WORK PRODUCT.

I HEREBY CERTIFY THAT THE ABOVE DESCRIBED PROPERTY HAS BEEN SURVEYED UNDER MY DIRECTION AND THAT THE ABOVE MAP IS A TRUE REPRESENTATION THEREOF AND SHOWS THE SIZE AND LOCATION OF THE PROPERTY AND ITS EXTERIOR BOUNDARIES. THIS SURVEY IS MADE FOR THE USE OF THE PRESENT OWNERS OF THE PROPERTY, AND ALSO THOSE WHO PURCHASE, MORTGAGE, OR GUARANTEE THE TITLE THERETO WITHIN ONE YEAR FROM THE DATE HEREOF.

DATED: 07/27/93

*Peter S. Gordon*

PROJECT NO. 2547.93

WUW-61

011-1001