


JEWELL DRIVE

LOT 39

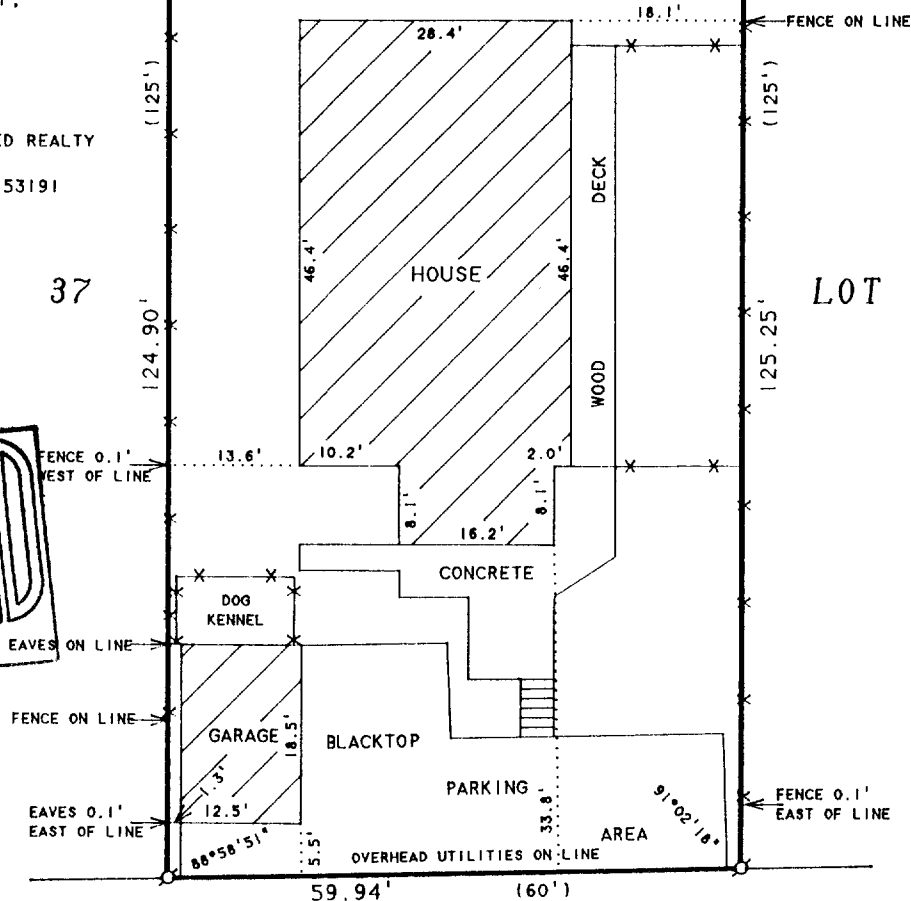

DATE _____ JOB NUMBER - _____
NOTE: THIS IS NOT A CERTIFIED COPY UNLESS SEALED. 93180