


# HAROLD H. KOLB

REGISTERED PROFESSIONAL LAND SURVEYOR  
LAKE GENEVA, WISCONSIN

HUMBOLT PARKWAY 50' WIDE

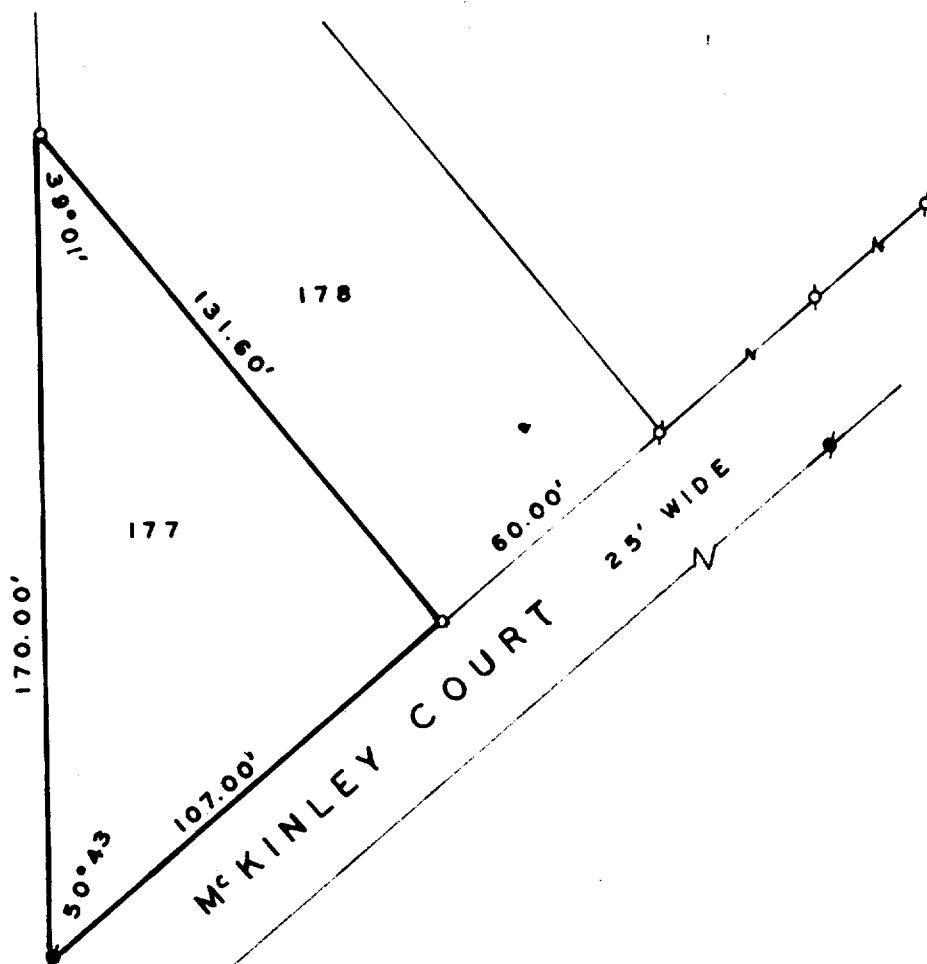

## LEGEND

- ⌀ — IRON PIPE FOUND
- — IRON ROD PLACED
- — CONCRETE MONUMENT
- x — SPIKE



## PLAT OF SURVEY OF

Lot 177, Cedar Point Park Subd.  
T. 1 N., R. 17 E., Village of  
Williams Bay, Walworth County,  
Wisconsin.

I, HAROLD H. KOLB, DO HEREBY CERTIFY THAT I HAVE  
SURVEYED THE PROPERTY HEREON DESCRIBED ACCORDING  
TO THE OFFICIAL RECORDS, AND THAT THE PLAT HEREON  
IS A CORRECT REPRESENTATION OF THE LOT LINES.

*Harold H. Kolb*

HAROLD H. KOLB

WISCONSIN REGISTERED LAND SURVEYOR, S-187

DATE April 17, 1969

11-101