
ABELL SURVEYING & MAPPING DELAVAN, WISCONSIN 53115 414-728-6737

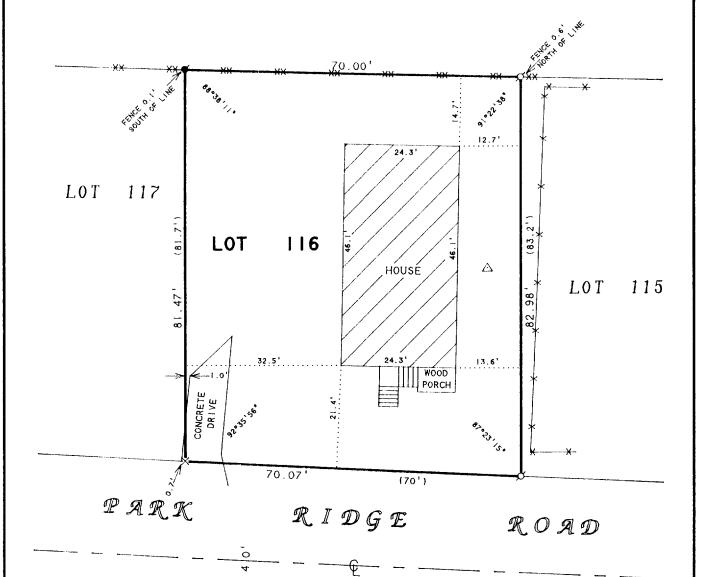


ORDERED BY: GILBERT NIZNIK 731 BARTLETT AVENUE PLAINFIELD, IL 60544

PLAT OF SURVEY OF

LOT 116. CEDAR POINT PARK 2nd ADDITION. LOCATED IN THE VILLAGE OF WILLIAMS BAY.

WALWORTH COUNTY, WISCONSIN

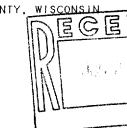

SCALE | "=201

LEGEND

Ø -IRON PIPE FOUND ■ -IRON ROD FOUND

-CUT CROSS IN

CONCRETE FOUND -CHAINLINK FENCE -WOOD FENCE

△ -TV ANTENNA)-RECORDED AS 1. DAVID F. ABELL. DO HEREBY CERTIFY THAT I HAVE SURVEYED THE PROPERTY HEREON DESCRIBED ACCORDING TO THE OFFICAL RECORDS AND THAT THE PLAT HEREON IS A CORRECT REPRESENTATION OF THE PROPERTY LINES TO THE BEST OF MY KNOWLEDGE AND BELFET

DAVID F. ABELL WISCONSIN REGISTERED LAND SURVEYOR, S-1596

April 22, 1994

DATE JOB NUMBER - 94052

NOTE: THIS IS NOT A CERTIFIED COPY UNLESS SEALED.