

KOLB LAND CONSULTING, INC.  
LAND SURVEYING • SUBDIVIDING • LAND PLANNING

LAKE GENEVA, WISCONSIN 53147

414-243-3697

ORDERED BY: BAY CONSTRUCTION CO.  
P.O. BOX 391  
WILLIAMS BAY, WI. 53191

PLAT OF SURVEY OF

LOT 59 OF THE ORIGINAL PLAT OF  
CEDAR POINT PARK AND LOT 227 OF  
CEDAR POINT PARK 3RD ADDITION,  
LOCATED IN THE VILLAGE OF WILLIAMS  
BAY, WALWORTH COUNTY, WISCONSIN.


NOTE: BEARINGS ARE ASSUMED AS  
SHOWN ON RECORDED SUB-  
DIVISION PLAT.



SCALE: 1" = 20'

LEGEND

- ⊕ - IRON PIPE FOUND
- ⊙ - IRON ROD FOUND
- - CONC. MONUMENT FOUND
- (50') - AS RECORDED
- - IRON PIPE SET

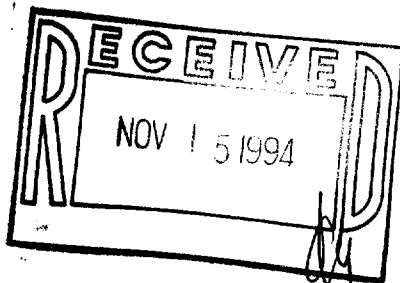

I, HAROLD H. KOLB, DO HEREBY CERTIFY  
THAT I HAVE SURVEYED THE PROPERTY  
HEREON DESCRIBED ACCORDING TO THE  
OFFICIAL RECORDS AND THAT THE PLAT  
HEREON IS A CORRECT REPRESENTATION  
OF THE LOT LINES AND THE PRINCIPAL  
LINES OF THE BUILDINGS, TO THE BEST  
OF MY KNOWLEDGE AND BELIEF.  
SURVEY NOT VALID UNLESS SURVEYOR'S SIGNATURE  
IS IN RED.

HAROLD H. KOLB  
WISCONSIN REGISTERED LAND SURVEYOR, S-187  
DATE JANUARY 10, 1994

WCP-44  
WCP3-23

11-1064